


Nov. 29 - 1910 Survey for Preston Blair & Sons Christianman
in N.W. 1/4 Sec. 17 - T. 6 - R. 11 W.

(68)

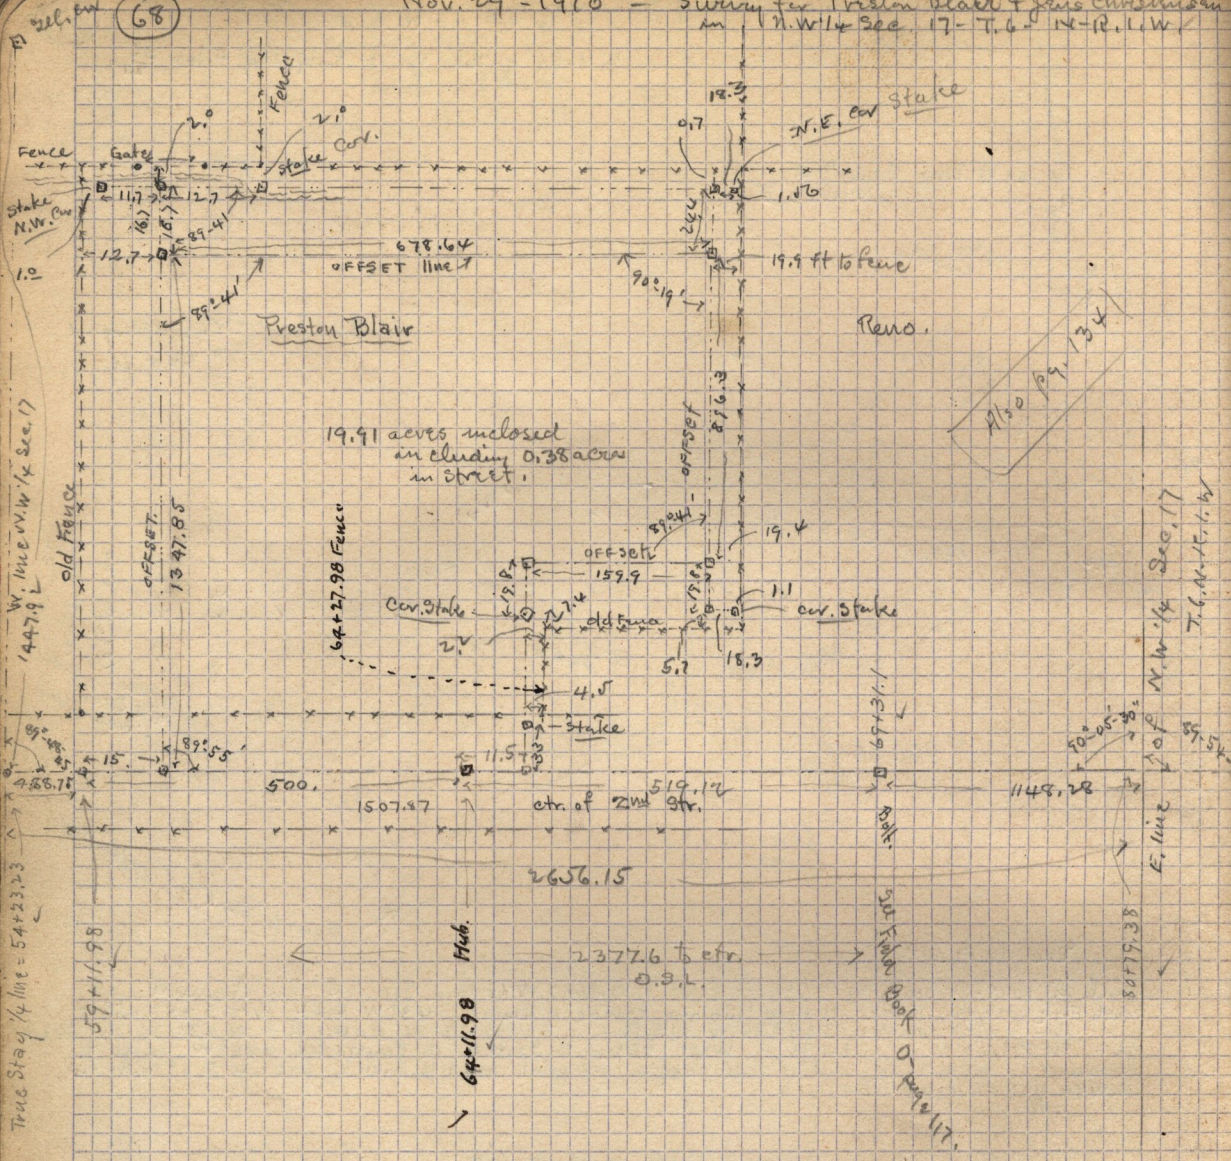

W. line N.W. 1/4 Sec. 17
1447.92

True Stag 1/4 line = 54+23.23

N.W. 1/4 Sec. 17

