


Page 71-72  
 Tam O' Shanter

See Field Book	F	p. 294
"	H	" 145
Co. Road	O	" 50
		" 30

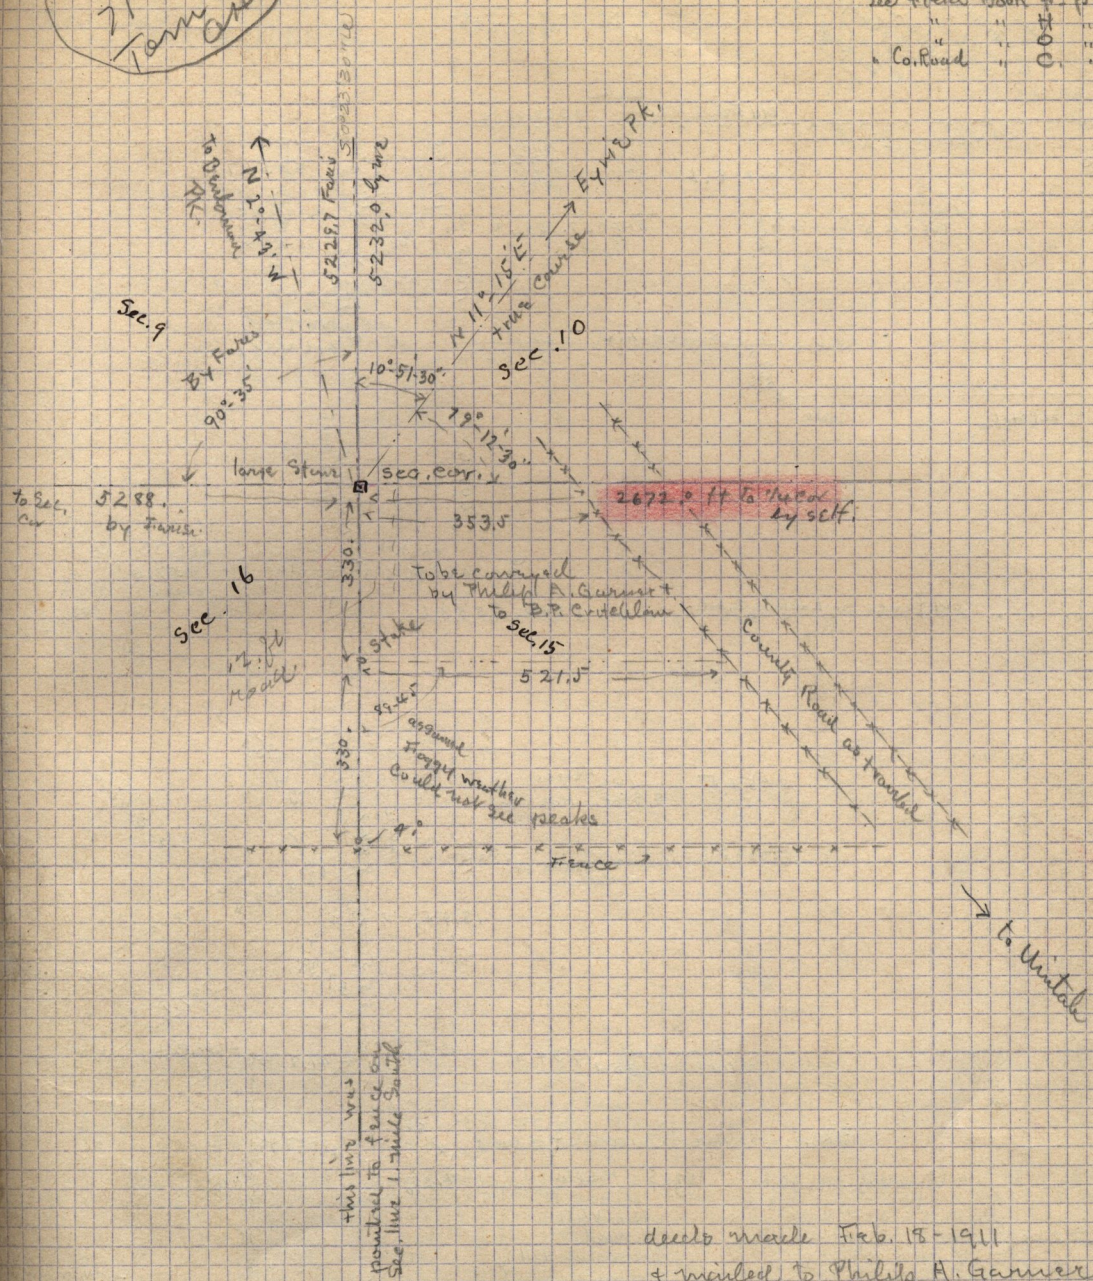

deeds made Feb. 15-1911  
 & mailed to Philip A. Garner  
 (Clerk - let.  
 (R.F.D. 4))