(30)

Feb 6-1911 -
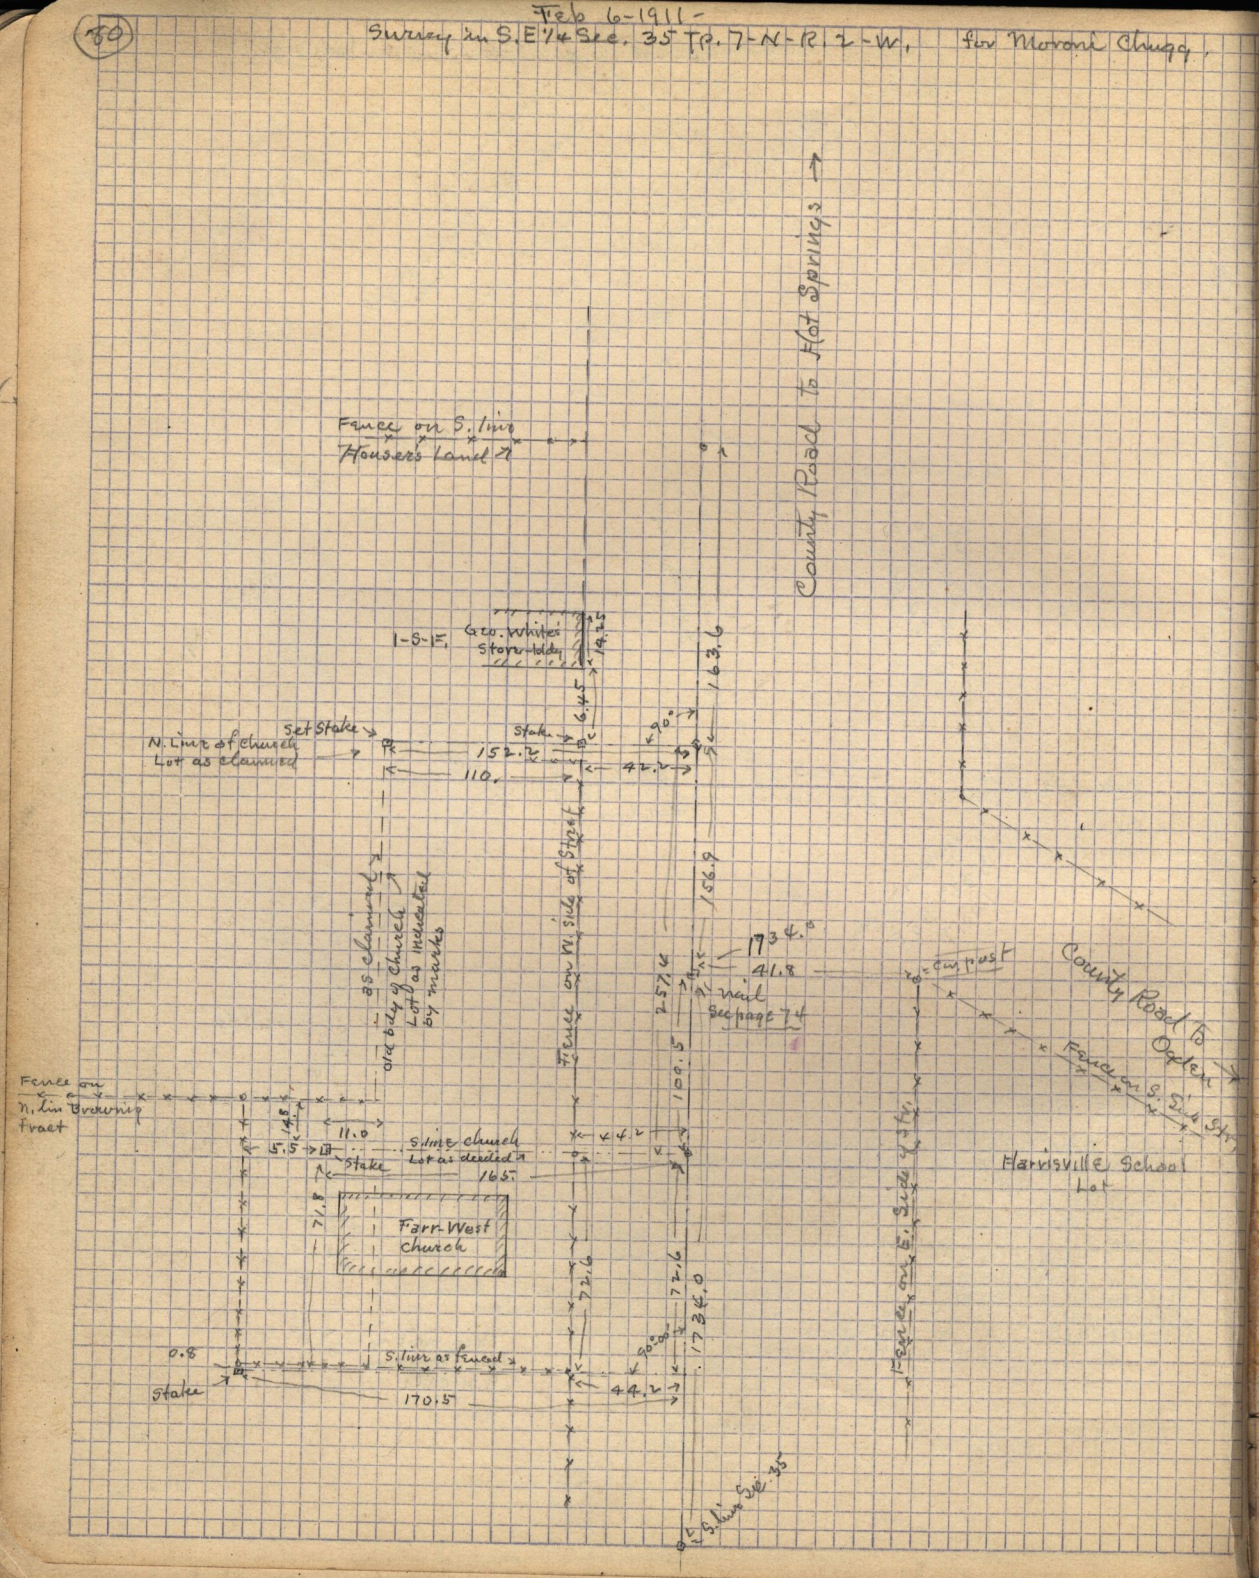
Survey in S.E¼ Sec. 35 Tp. 7-N-R 2-W, for Morani Chupp.