

Survey for Jos. Smith and James Surrage April 17-1911


65-34 - Union Pacific R.R. Co. to Jos. Smith and James Surrage - date Nov. 29-1910 - $\frac{1}{2}$ Acre 480, S.W. $\frac{1}{4}$ of N.E. $\frac{1}{4}$ and S.E. $\frac{1}{4}$ of Sec. 15 - T. 6. N. - R. 2. E. 240. a
Recorded Feb. 11-1911

James Surrage & wife
Lilly Surrage
to Joseph Smith (E $\frac{1}{2}$)

Joseph Smith & wife
Elizabeth Smith
to James Surrage (W $\frac{1}{2}$)

deeds made out
& sent to Hanksville
April 21-1911

See page 95
for survey of Sec. 9

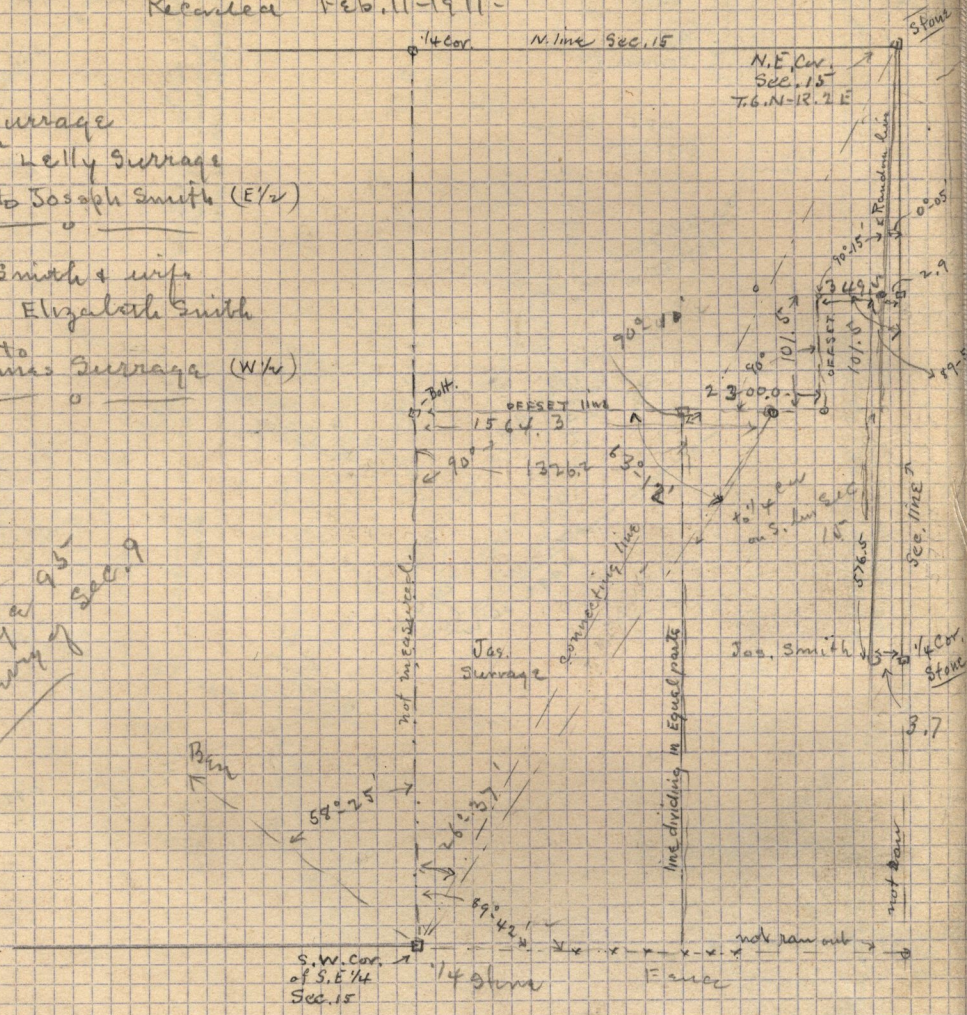

Jos. Surrage

Jos. Smith

S.W. Cor. of S.E. $\frac{1}{4}$ Sec. 15

Stone

1/4 Cor. Stone