May 5 - 1911

Survey of Pt. Lot 1 Blk. 7 - Plat B - Ogden City Sur.,
for. B. Oppman. or Rosa Rosenbluth
being the East 66. ft. of said Lot 1 -
Fred Naisbit assist.

93
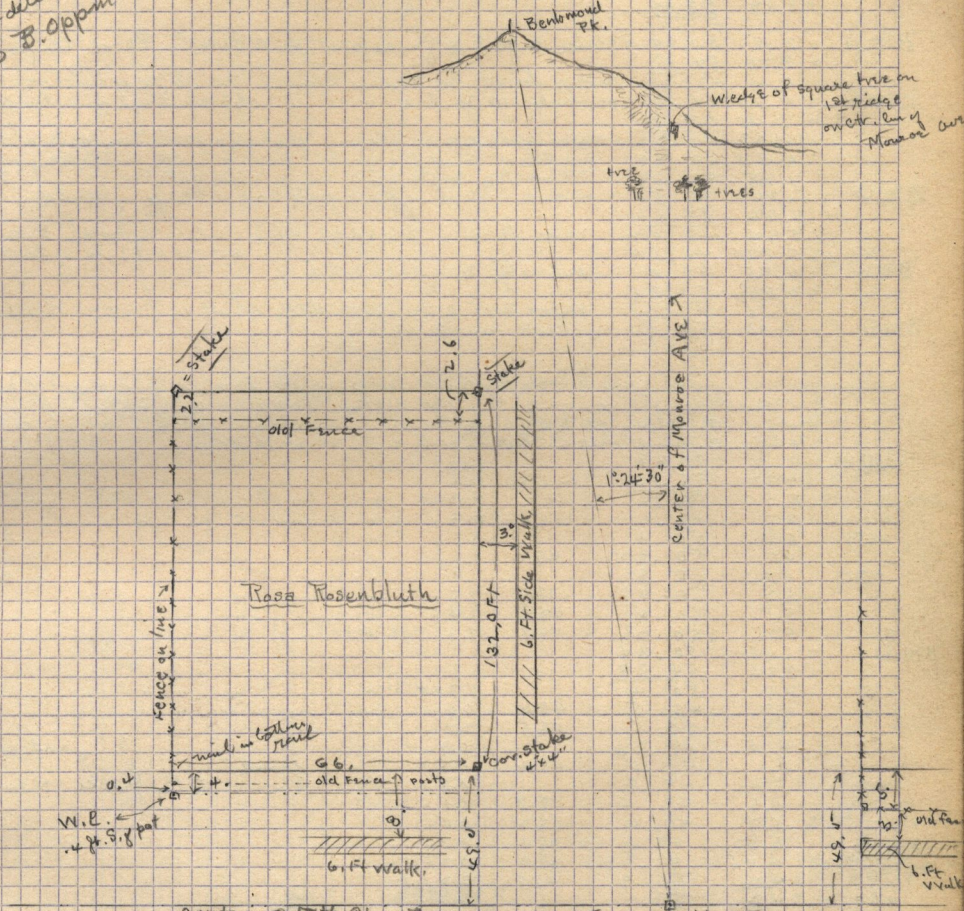
Certificate made out
May 6 - 1911 - & delivered
To B. Oppman.