March 28-1911

(100) Survey of N 34. ft. of Lot 7- Reeves Add. for. John Wotherspoon.

Reeves Add. Recorded in Plat Book 3-p. 27 - County Records.
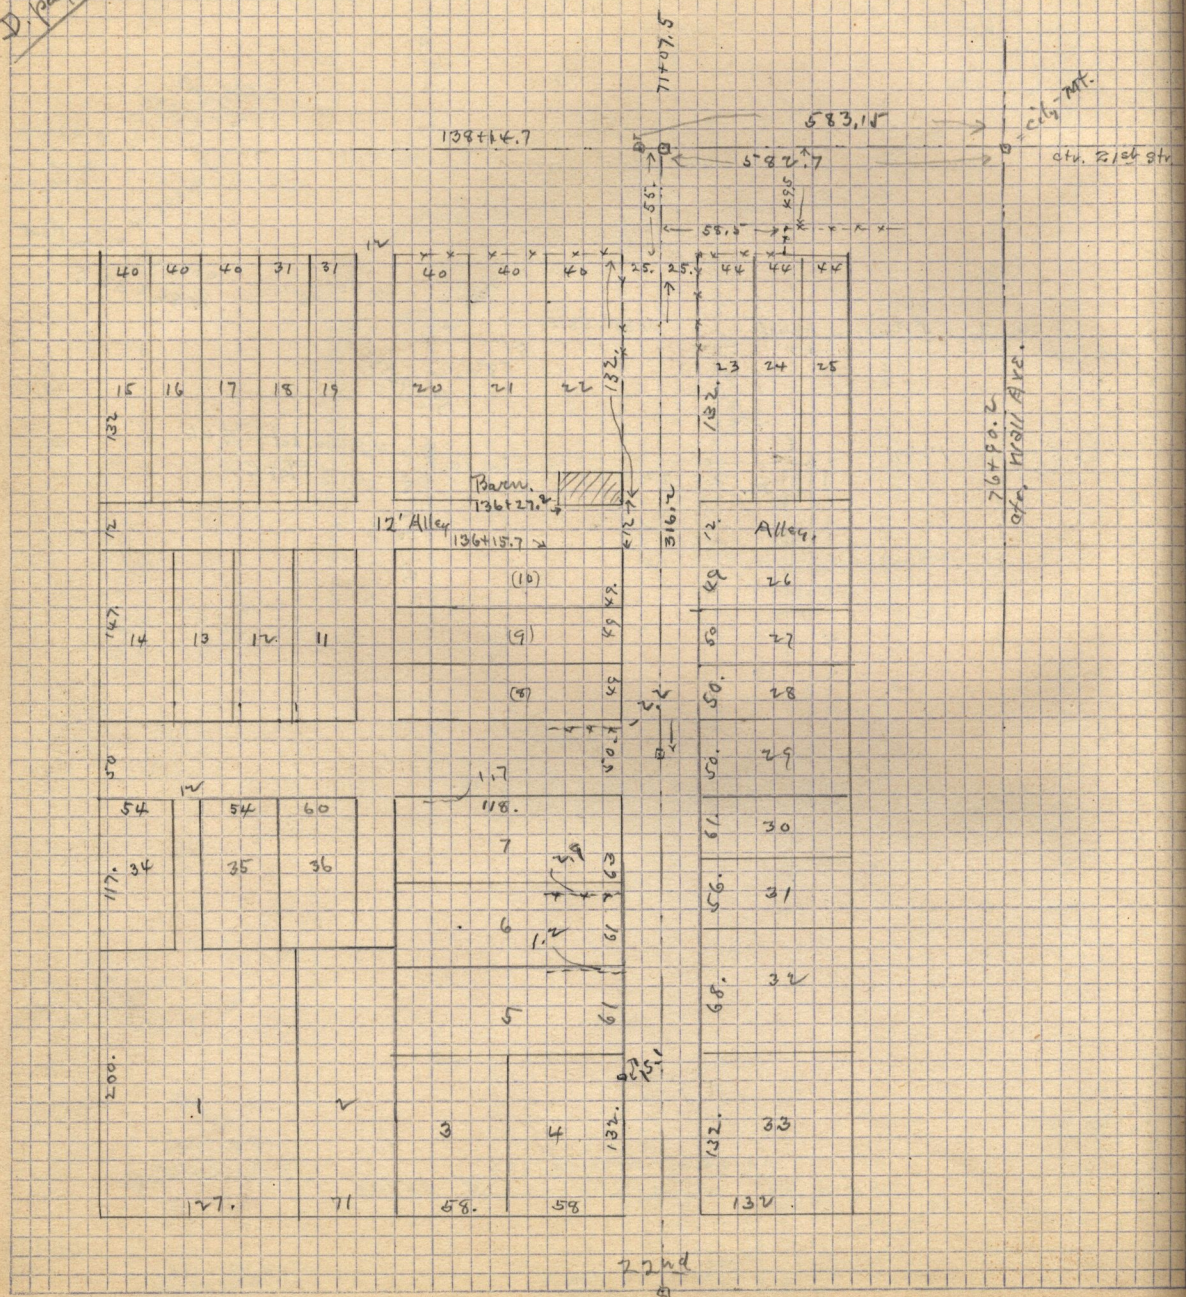
See Field Book D. page 127