

114


Sept 1-1911

Also see 9th 11th

1800. A. B. Arnold
1964. Jackson

Farm Development

Co
S.E. 1/4 Sec. 21
Ran Jackson
ave. to intersect
Street Car line
Carl Filigosa asst
4 days - 6th 7th 9-11th

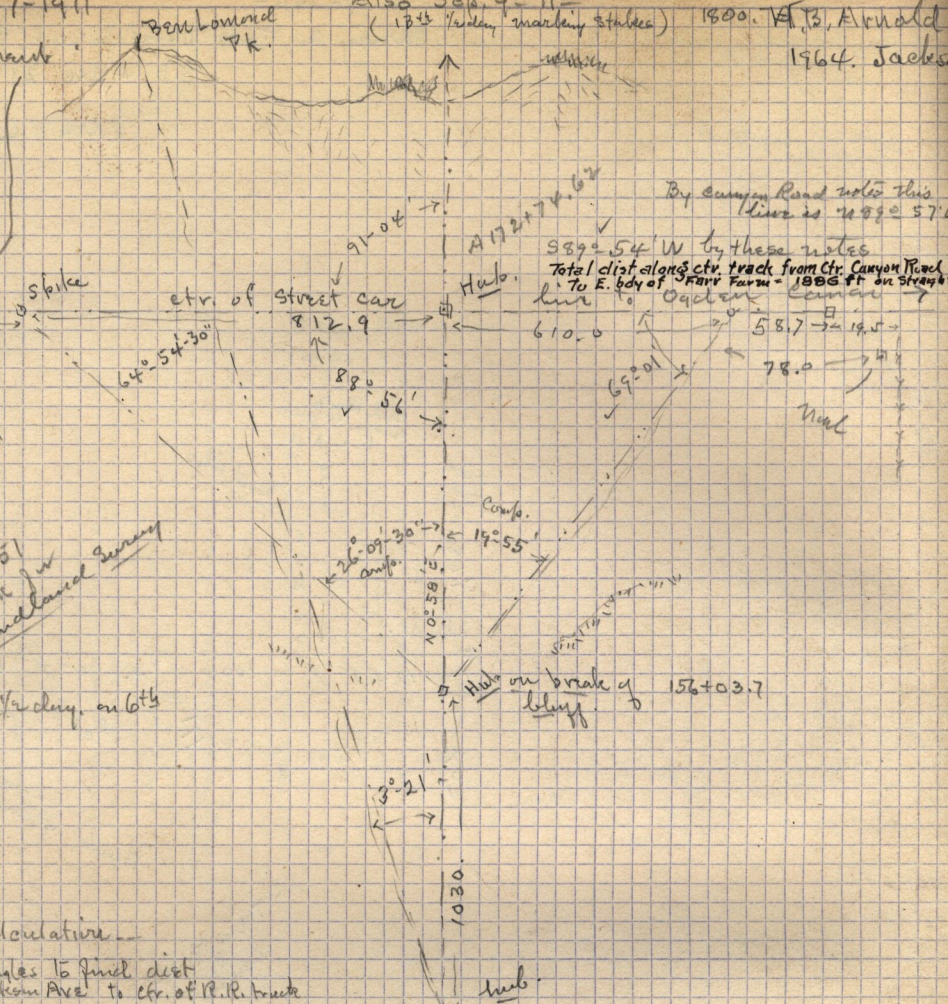

Tracy + P also assisted on 9th + 11th

See Plat Book
p. 89

See also p. 151
this book for
condemned quarry

Alphonso helped survey on 6th

Sept 8-1916 - Calculative

Solution of triangles to find dist
along ctr. of Jackson Ave to ctr. of R.R. track

(1)

sin	26°-09'-00"	=	9.4442940
ac		=	0.3557060 ✓
"	64°-54'-30"	=	9.9569510 ✓
log	812.9	=	2.9100371 ✓
	1669.91	=	3.2226941 ✓
			<u>3.5</u>

(2)

sin	19°-55'	=	9.5323123
ac		=	0.4676877 ✓
"	69°-01'	=	9.9702002 ✓
log	610.0	=	2.7853298 ✓
	1671.93	=	3.2232177 ✓
			<u>10.3</u>
			<u>74</u>

mean of (1) + (2) = 1670.92

145+73.7 → ctr. 20th str.
1030.
Hub
Hub on break of lobby
156+03.7
Cfr. Jackson,