


Survey for T. & John Thompson = Sec. 18-19-20 T. 5-N. R. 1-W

array 24 - 1912  
 " 25 - "  
 " 26 - 1912  
 " 27 - 1/2 in = 4' delays  
 " 28 - 1/2 in = 4' delays

125

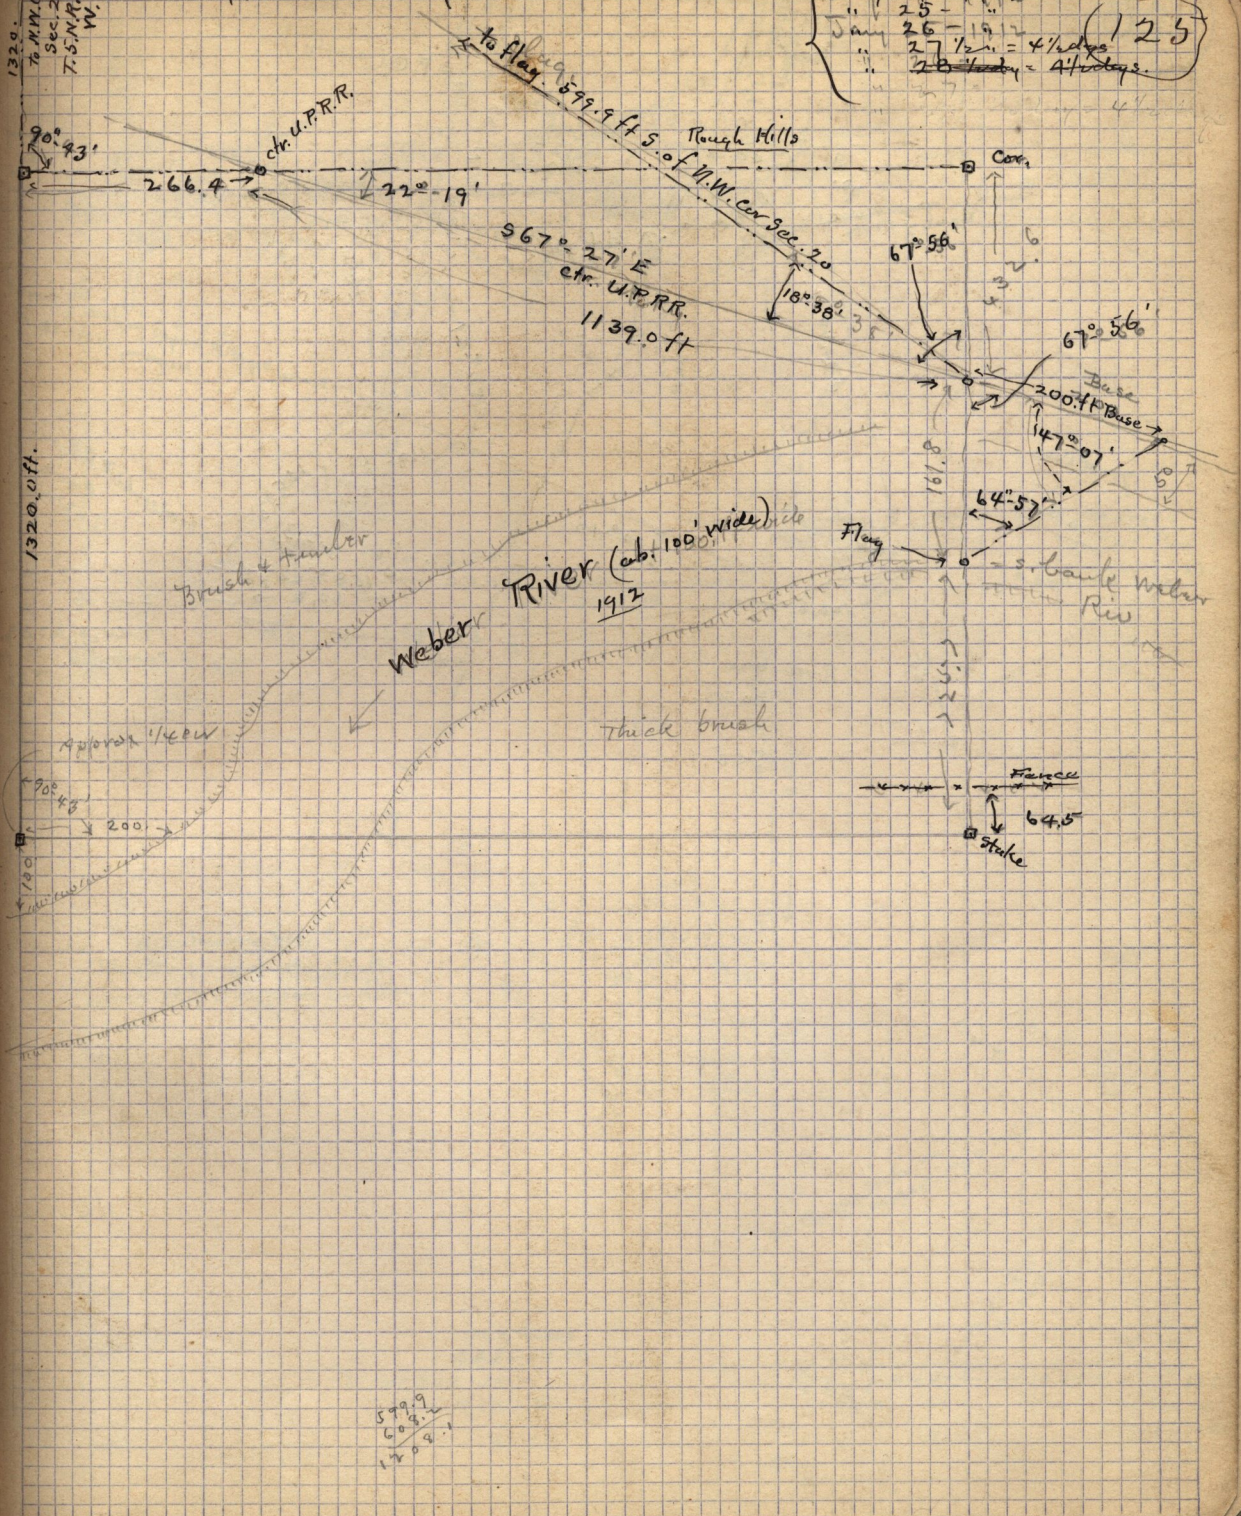

599.9  
 608.2  
 1208.1