May 19th 1917
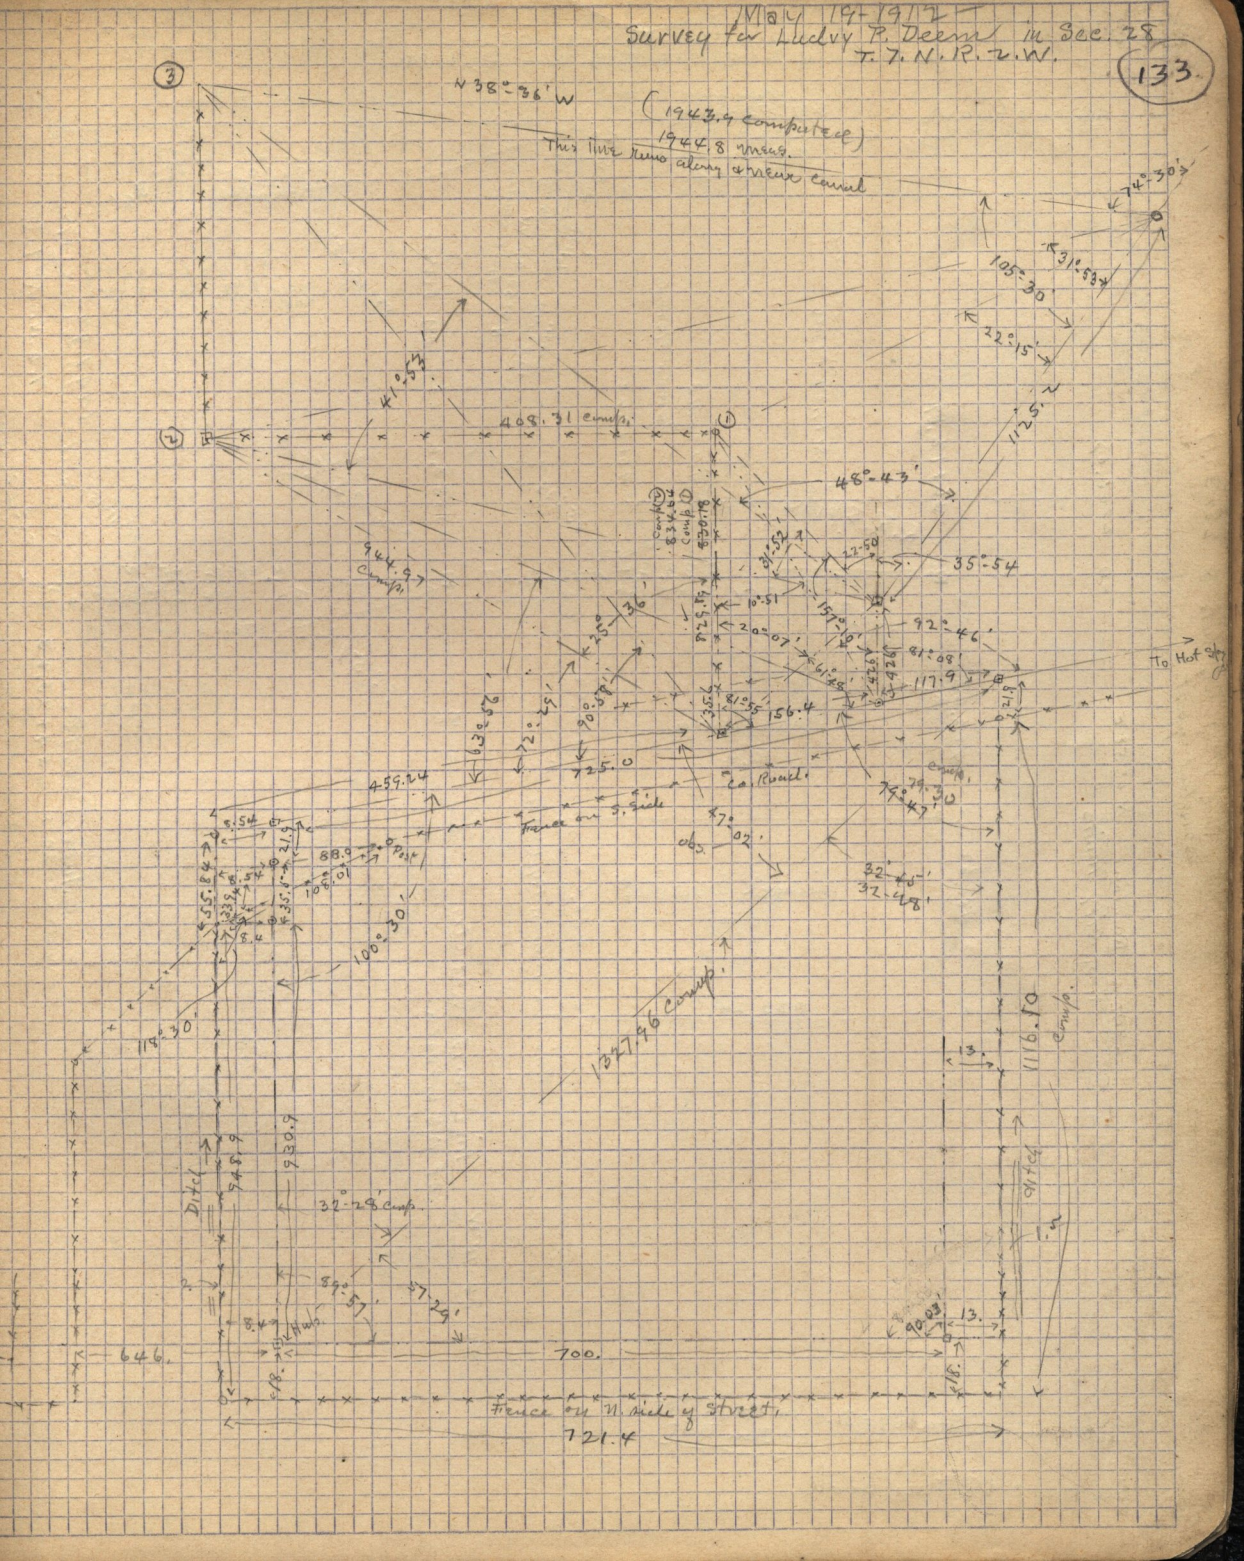
Survey for Audley P. Deems in Sec. 28 T. 7. N. R. 2. W.