Feb 8-1913

Survey for Ogden Milling and Elevator Co.
in N.E¼ Sec. 18- Tp. 5-N-R. 1 W.

See Field Book page 153

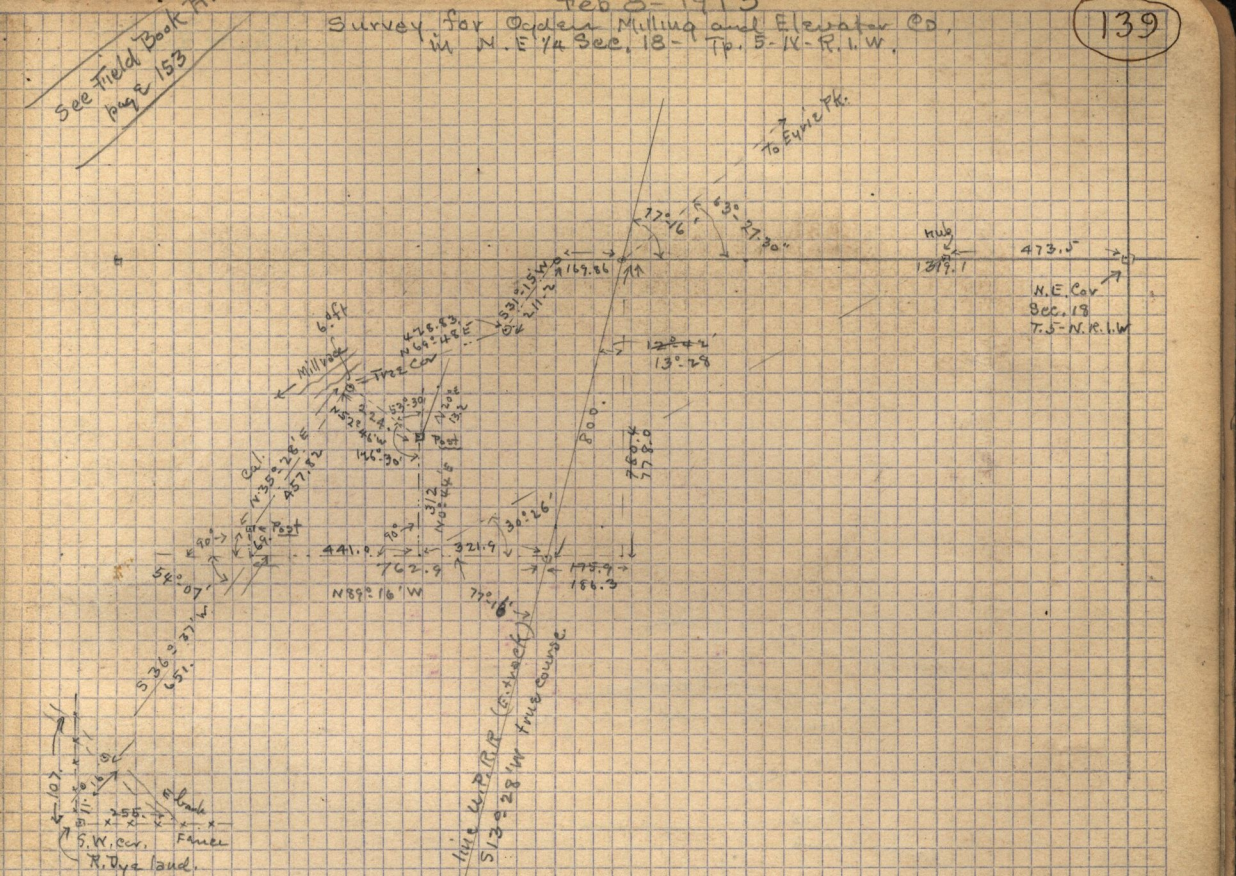

Traverse table of piece cut off Milling Co. land & deeded to Jevald or Dye, beg. 22.54 ch W. and 3.20 ch S 31°-15'W of N.E. cor. Sec. 18 - T.5 N - R.1.W. — See map. No 380 —

		N	S	E	W
S 31°-15' W	151.8 ft		129.77		78.15
S 57°-00' W	132.0		71.89		110.71
S 20°-00' W	132.0		124.04		45.14
S 41°-30' W	200.64		150.26		132.94
S 58°-15' W	310.2		163.23		263.76
S 66°-00' W	194.03		78.92		177.26
N 35°-28' E	699.87	570.01		406.08	
N 69°-48' E	428.83	148.10		402.45	
		718.11	718.11	808.53	808.56

Traverse table of line ran S 13°-28' W. along Ctr. of Ry. and W. side U. to locate Post. - and also tree on Mill Race

		N	S	E	W	
S 13°-28' W	800. ft.		778.0		186.3	along ctr. of U.P.R.R.
N 89°-16' W	321.9 "	4.02			321.21	on offset line
N 0°-44' E	312.0 "	311.97		3.99		to post in Fence recognized by owners as Corner.
N 52°-46' W	224.0 "	135.53			178.34	To line tree 6' E. of E. bank of Mill race - being point on new Boundary.

Traverse table of line - beg. at same point in ctr. of Rail Road on N. line of Sec. 18, and ran W. and S.W. to same tree cor. as above, in order to compute one omitted line.

N 89°-16' W	169.86 ft	2.17			169.85	along N. line of Sec. 18. to cor. in Mill Race
S 31°-15' W	211.20 "		180.55		109.56	to new cor. thence Calculate To tree cor.
S 69°-48' W	428.83 "		148.10		402.45	To tree cor. 6' E. of E. bank (along new boundary.)

Traverse Table - beg. at tree cor. 6' S. of E. bank of Race - S. & W. to another post on New boundary

S 52°-46' E	224 ft.		135.53	178.34		
S 0°-44' W	312. "		311.97		3.99	
N 89°-16' W	441. "	5.64			440.96	
N 0°-44' E	67.0 "	66.99		.38		
N 35°-28' E	487.82 "	402.32		265.78		along new Bdy to tree cor. 6' E. of Mill Race