

132.

- 1 25
- 2 25
- 3 25
- 4 25
- 5 25
- 6 25

walnut Str.

244+56.1

244+23.07

90°
 243+76.47 ctr. 3rd St.


Stake 1. off
 N. of frame

N. Line Orchard Grove Annex
 N 88° 01' 45" W

Stake 47 N. of Fence

242+41.64

8.0

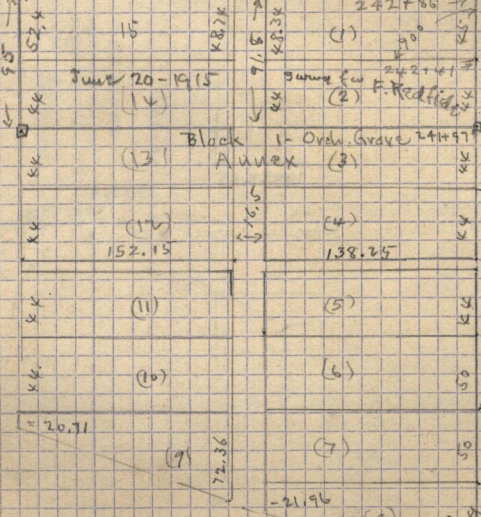

242+86
 242+41
 242+54.55
 242+56.50
 242+41.15

N 00° 50' 15" E
 ctr. Washington Av.
 # 857 7 from Mt.

240+17.05

238+91.3 238+90.11

1.9 ft. N. of fence

238+69.05

N 89° 09' 45" W

4 46 Str.

237+44.87

237+11.96

237+32.39 ctr. 5th East