Continued from page 145

(146)

March 6-1916 –
Preliminary survey for Ogden Packing Co
in N.E. 1/4 Sec. 30 Tp. 6. N – R. 1. W, W. A. Harrop, E. Jenkins assist
I begin at hub. 30. ft. N. of City Mont in ctr. 21st Street, (1/2 d
on E. line of said 1/4 Sec. Said Mont being 2240.59 ft. W. of
ctr. of Wall Ave, in ctr. of Street and 40.27 ft W. of ctr. D. & R. G. Spur and 212.25 ft. W. of ctr. old C.P.R.R. main
measd by City surveyors Lentz & party
and run West parallel to ctr. of Street

See page (69)

275.6	=	ctr. of Plain City Canal ring North
296.0	=	line of fence runs South.
298.4	=	" " " " North.
379.5	=	" " " " South (Deeds give this distance 378.8)
503.	=	ctr. of Middleton ditch runs N.W.
515.8	=	line of fence runs South (deeds " " " 514.8
566.1	=	" " " " South
⊡ 600.0		Set hub from which N.W. 39.3 to pole S.W. 41.0 ft to pole
694.4	=	line of fence runs North (deeds give this dist 693.0 ft)
892.2	=	" " " " " on E. side of lane
924.5	=	" " " " " " W " " " (deeds give this dist 924.0 ft)
1067.8	=	" " " " "
1118.3	=	" " " " "
1193.7	=	" " " " " (deeds give this distance 1194.0)
1259.7	=	" " " " " (deeds give this distance 1260.)
1359.8	=	" " " " " (" " " " 1360.)
⊡ 1400.0		Set Hub from which N.W. 19.0 ft to Pole S.W. 42.1 ft to Pole N. 17.65 to Str. fence
1525.5	=	line of fence bears N.W. on E. side of lane
1556.0	=	" " " " " " W " " "
1693.5	=	" " " " S.W. on D & R.G. Rt of Way.
1875.6	=	ctr. line main D. & R. G. R.R. track N.E. Δ 19° 31'

Cold day storm
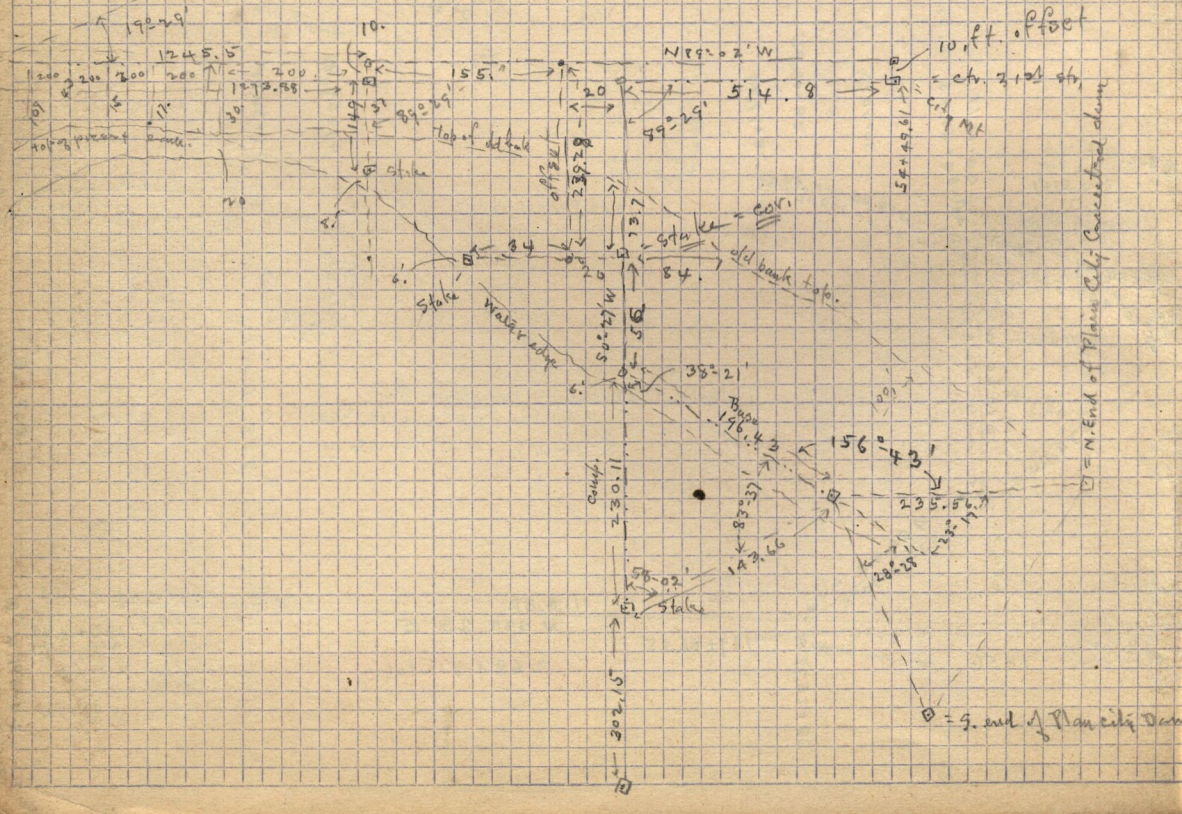
March 9 & 10 1916