


See box E 75-81-6-7
See Flat Book P. 89

April 7-1916 - Survey for lot, Carlsbad in S. E. 1/4 Sec 21 - T. 6. N. W. 34. at point which is 841.5 ft. W. ^{cont.} 1546.52 ft. N 52° 15' E, ^{cont.} 1575.3 ft. W. of S. E. Cor. ad 1/4 Sec. and point being on S. line Canyon Road, or 16th St. Run thence S. W. by along S. line said Road 365. ft. more or less to W. line of 1/4 Sec. thence S. 69° 51' W. more or less to point 727.6 ft. N. of S. W. cor 1/4. - thence S 79° 25' E 285.3 ft. - - N 57° 00' E. to point, S. of box, hence N. to box.

Certificate issued Apr. 25-1916

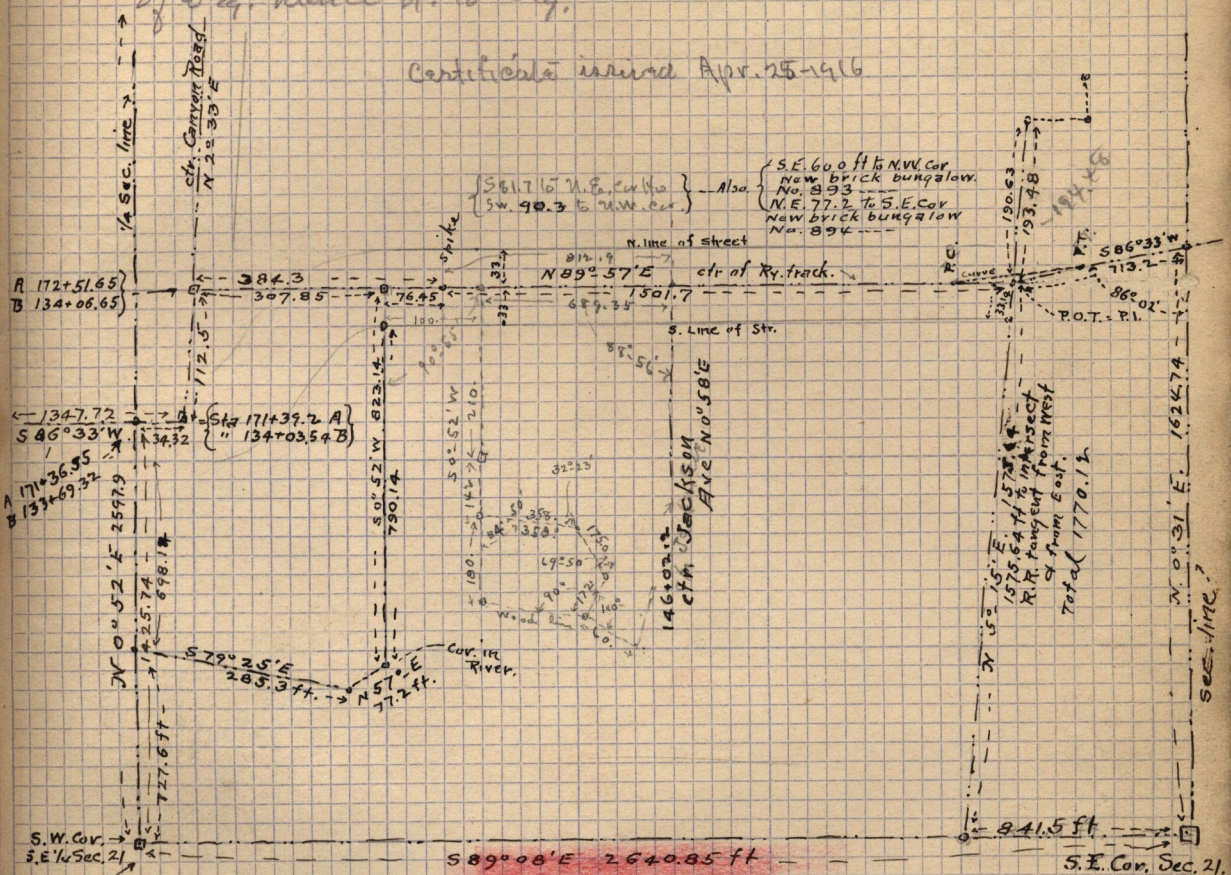

S.W. Cor. S.E. 1/4 Sec. 21
{ A 157+10.78 }
{ B 133+73.05 }

Nov. 23-1916

Made survey for P.A. Dix & E. J. Harness, of slough and wood lines on above

Traverse of S. bank of slough

	N	E	W
S 83° 58' E	358.0 ft	37.63	356.00
S 51° 35' E	175.0 "	108.74	137.10
S 18° 15' W	172.0 "	163.35	53.86
S 61° 45' E	60.0	28.40	52.85

S.E. Cor. Sec. 21, T. 6. N. R. 1. W.