(4)

Oct 25 - 1916

Survey for Shupe Williams Co. Pt. Lot 8 - B1

Ogden Sacre Plat A.

Beg. at N.E. cor. Lot 8 - Thence S. 181.5 ft
West 148.5 - N 181.5 ft. E. 148.5 ft. to Beg.
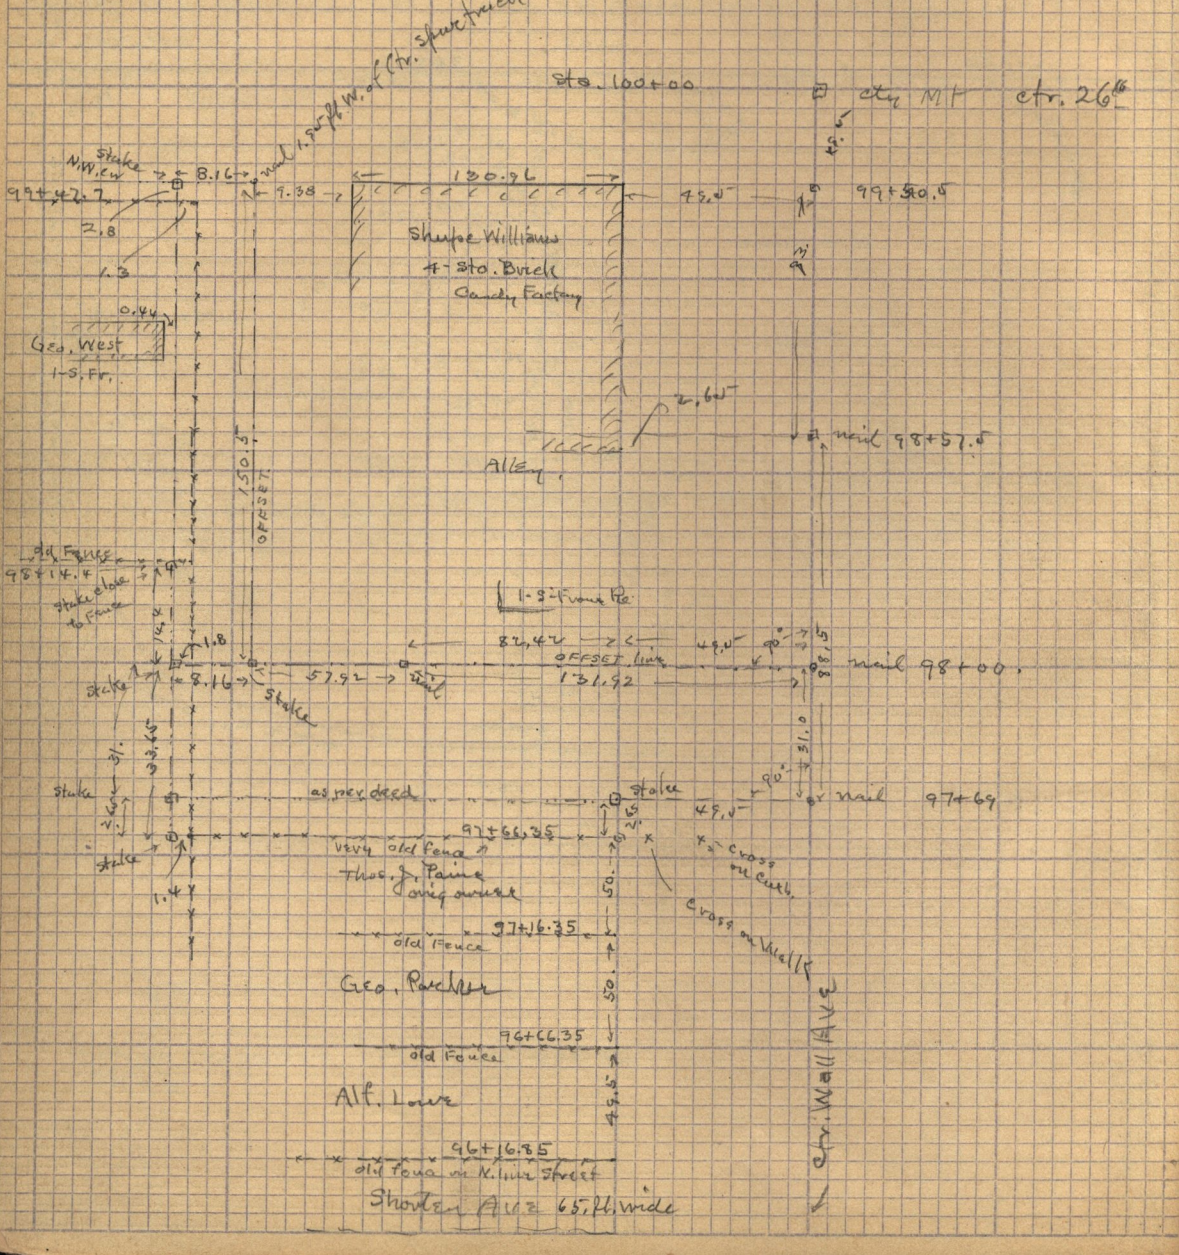
Note! There is 2.65 ft. surplus — included within the enclosure on S. Side — makes 184.15 — The owners to the South each have their paper amount within fences — (J)