"May 31- 1917-

Survey for Geo. W. Asper in S. ½ of ¼ Sec. 6
Tp. 6 N. R. 1. W

G.W. Asper & Sow Chamberlain

See Plat Book 4 pg 53

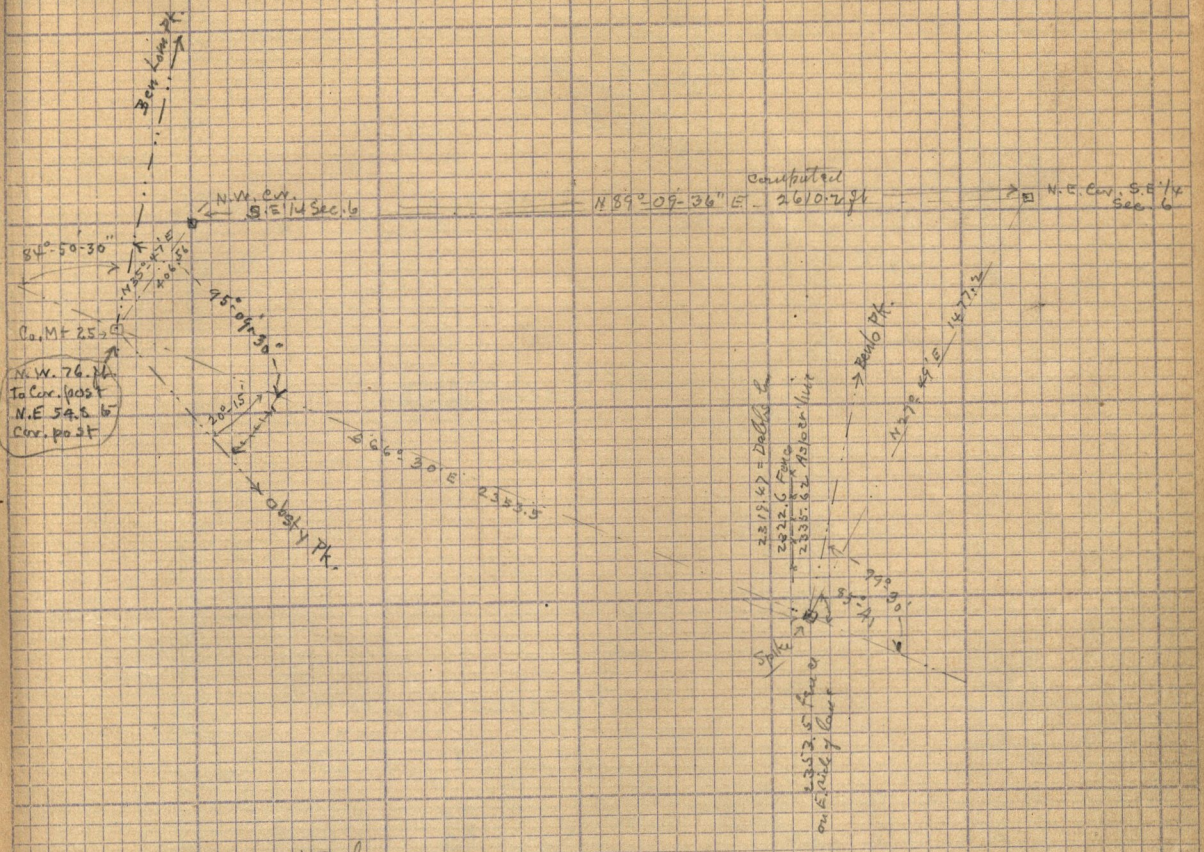

at entrance to lane
11.7 ft. W. & 18. ft. S. to each fence
fence Ncs 33.6 W. runs N 1°-57' E. along Aspers W. fence
about 30. ft. N. in lane
W 7.4 – E 26.2 to fence

W. 3. ft. to 29.5 E. to fence

Aug. 12 – 1920.

R.P.s to Co. Mont No 25. N.W. 82.7 to Hub. in pond. 4. ft. S. of fence 17. W. of Cor
N.E. 53.6 " " " " 4. " S. " Ridge 16. E. " "
S.E 67.4 " " " " 4. " N. " " 5. " " Str.
S.W 45.8 " " " " 4. " N. " " 5. " "