


Ctr. Harrison Av.

See Field Book page 57-61-62

To Locate 2 points of diversion of natural Separate Waters in S.W. 1/4 Sec. 34 T. 6. N. R. 1. W. cycle closed Pure Hale abnomin

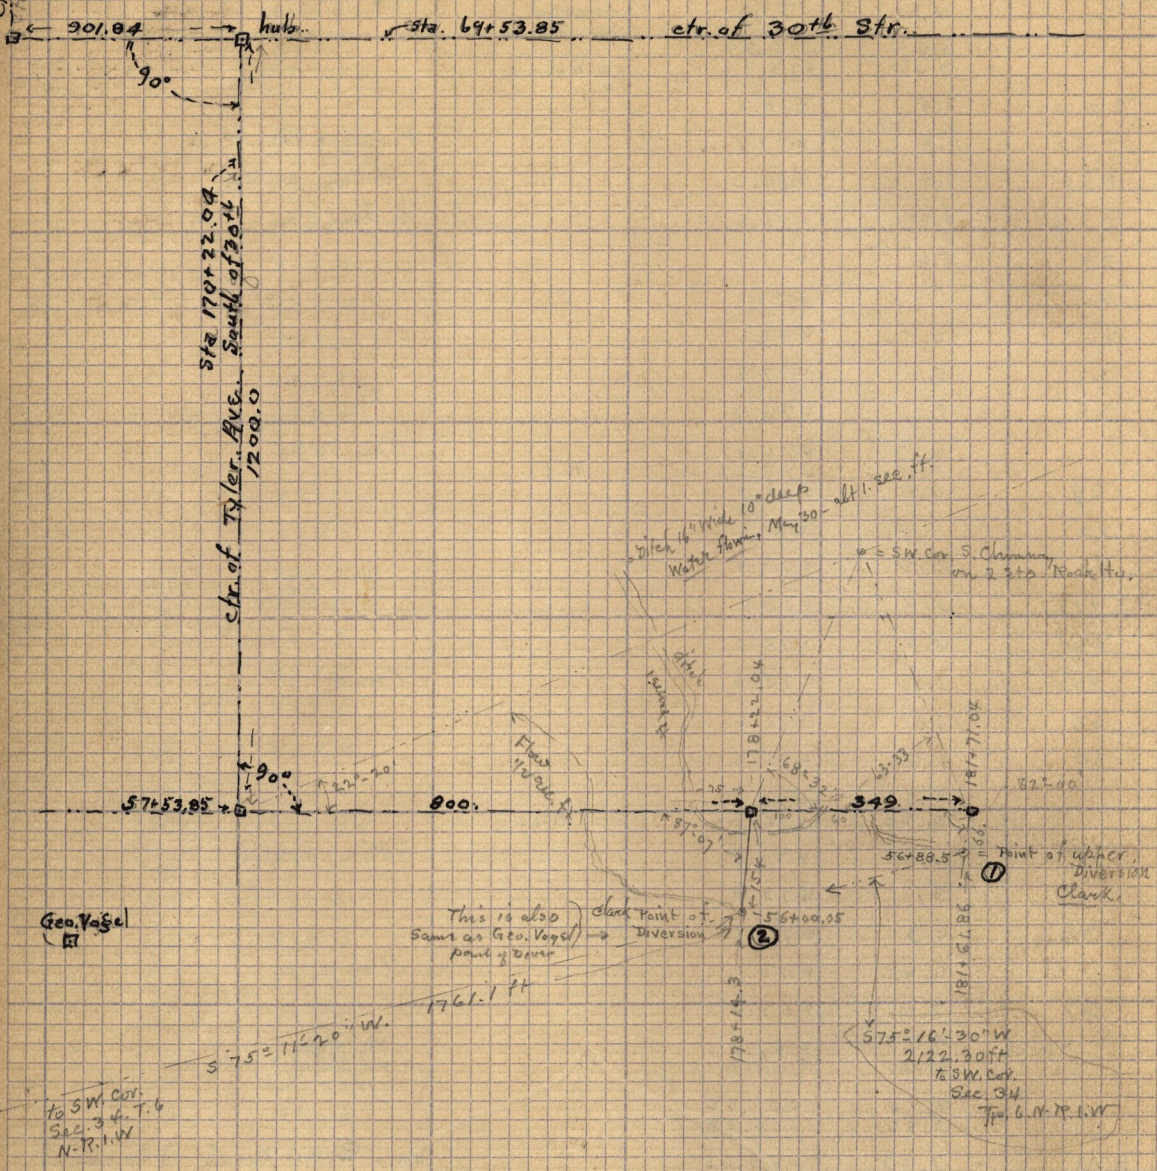

note - Flow of 1.5 Sec. ft = 1 acre ft every 8 hours or 3 acre ft every day of 24