See Book H. pg. 121. Sec. 31 - Tp. 6 N - R. 1 W June 14 1919

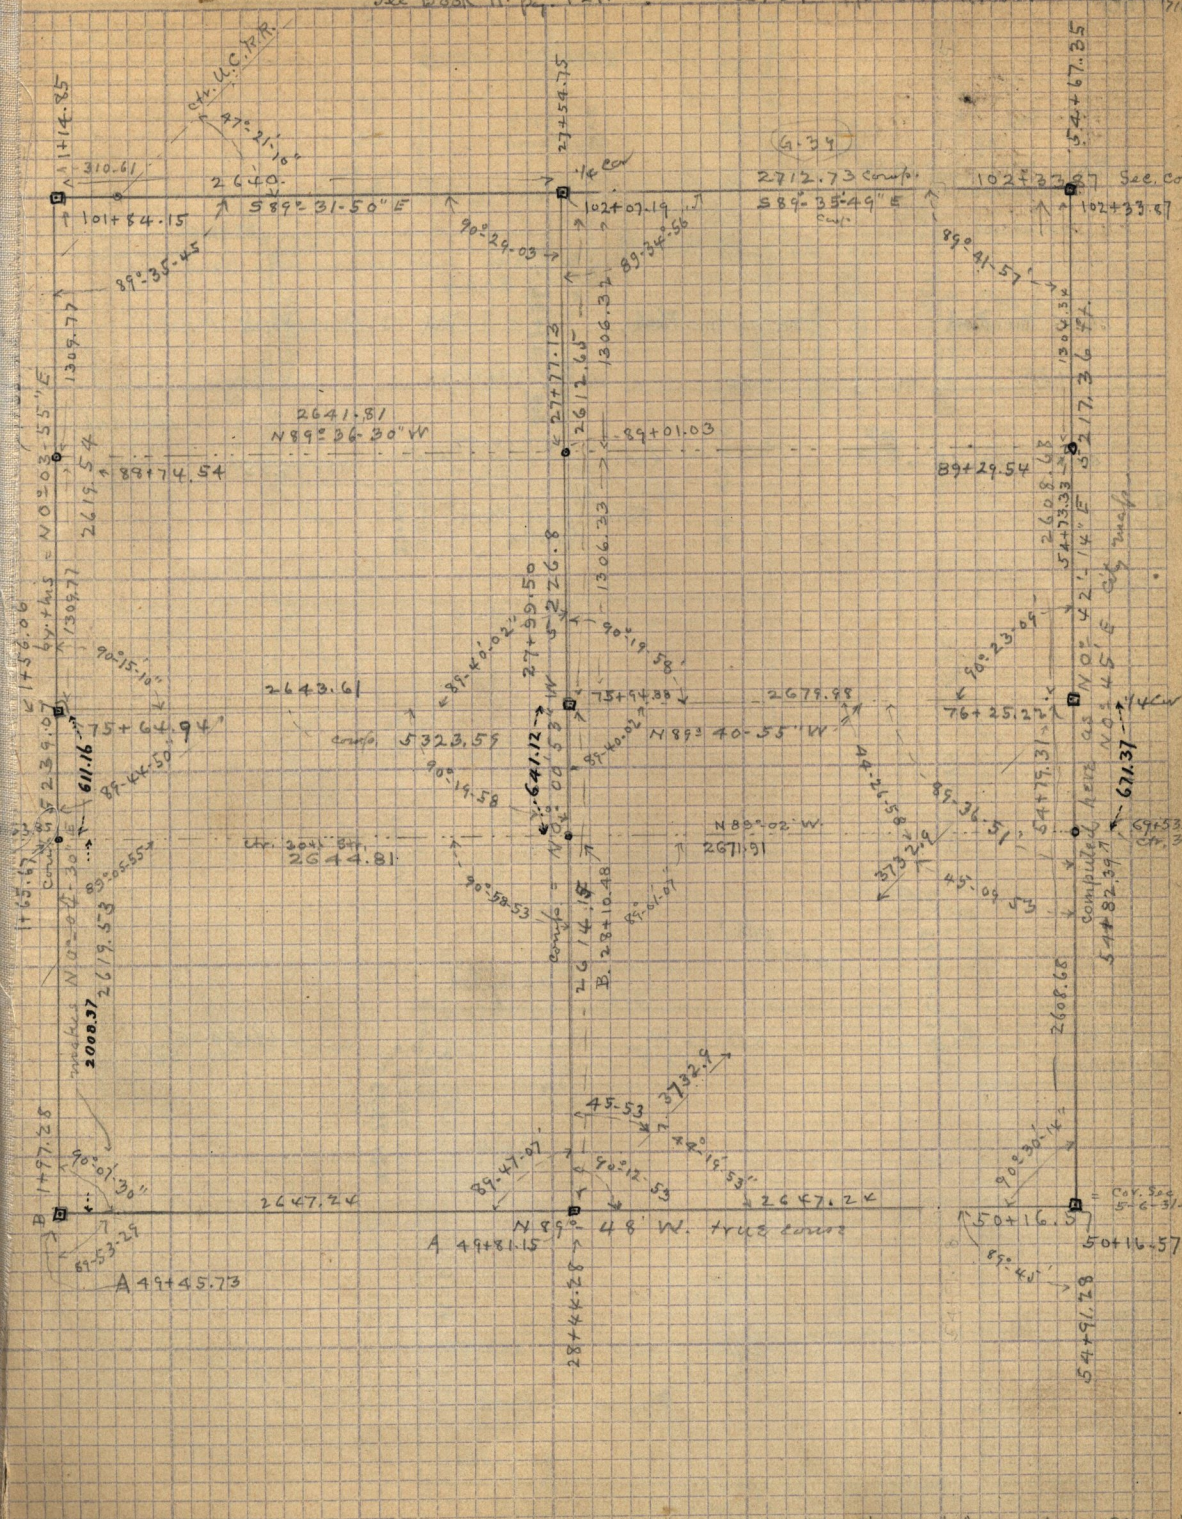

Sta. Ctr. Wall Ave = 76+90.2

along Ctr. 30th 4879.72 ft. from Ctr. Wall to Ctr. Sec. 31 at Sta 28+10.48