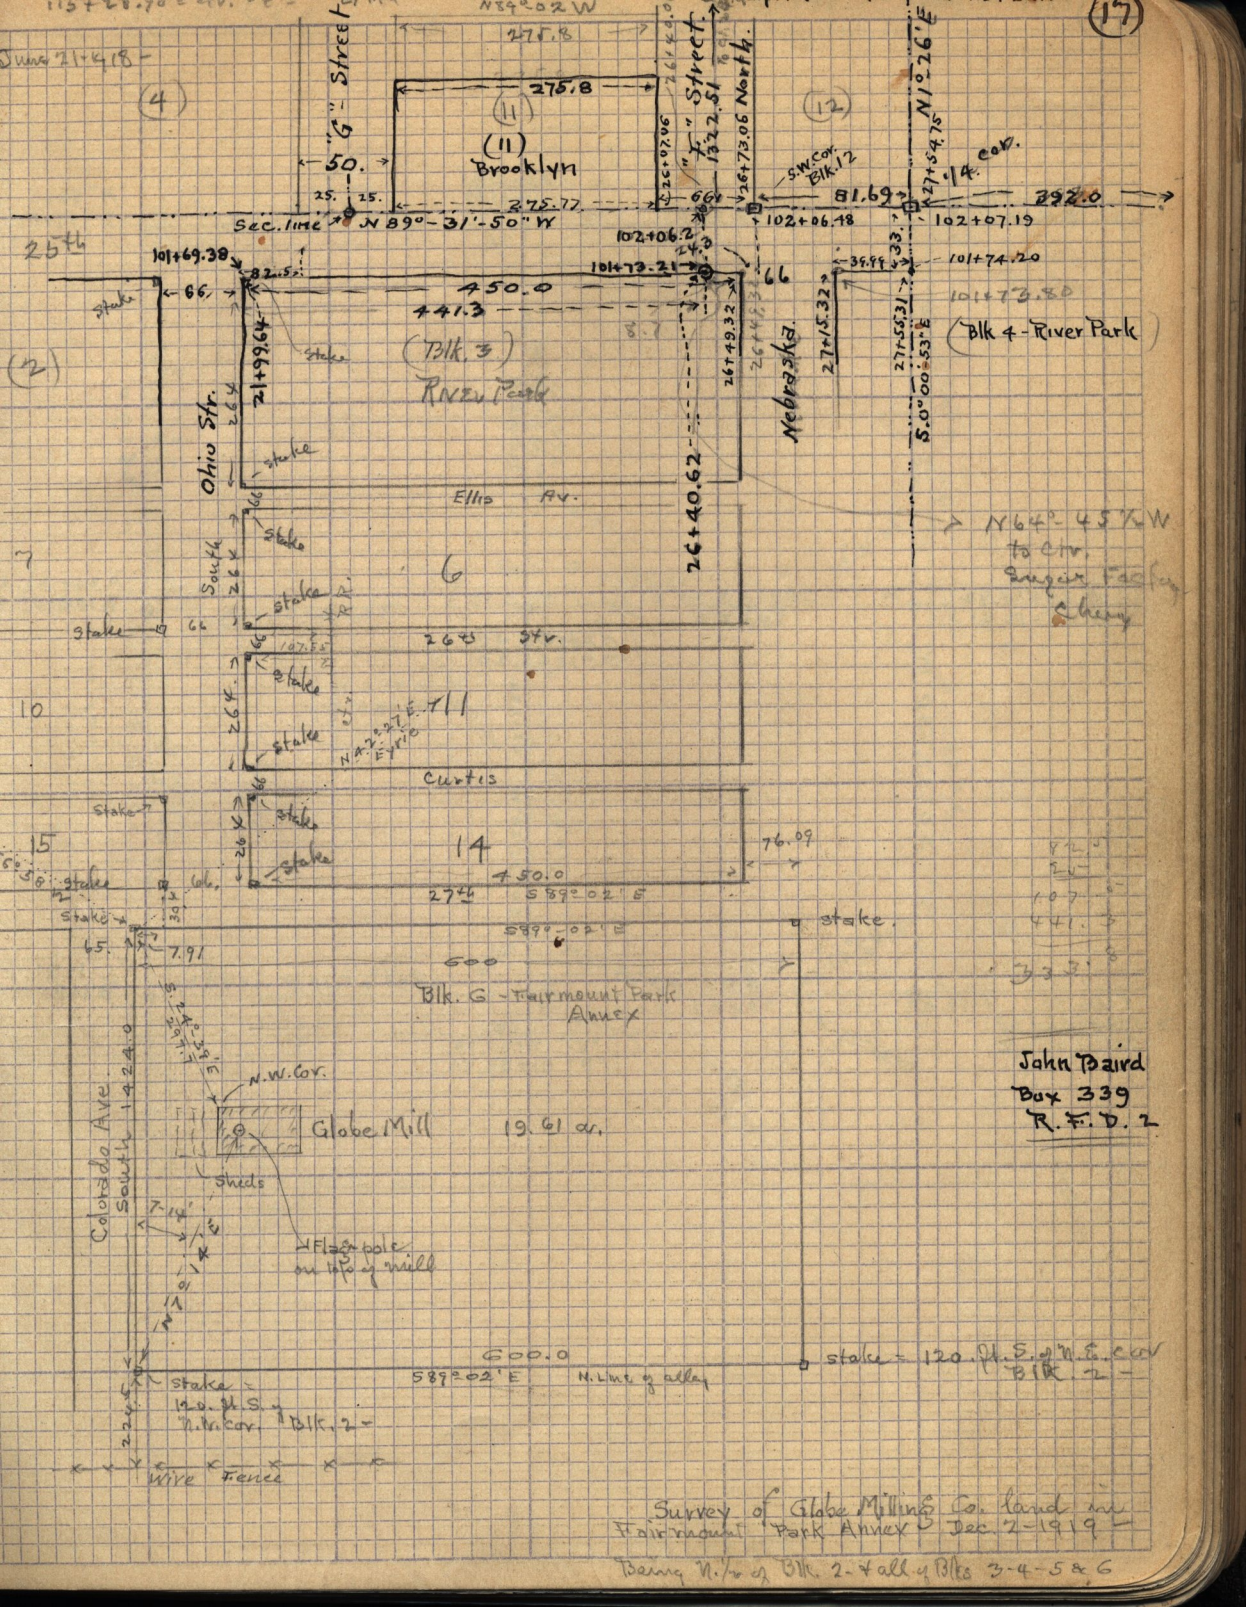
(17)
June 21-1918
(4)
"G" Street
N89°02'W
275.8
275.8
(11)
Brooklyn
50.
25.
25.
275.77
Sec. line
N 89°-31'-50" W
"F" Street
1322.51
26+07.06
26+73.06 North
S.W. Cor. Blk. 12
81.69
102+06.48
102+07.19
N1°26'E
27+54.75
14 cor.
392.0
25th
101+69.38
82.5
66
450.0
441.3
101+73.21
102+06.2
24.3
66
39.99
33.
101+74.20
101+73.80
(Blk 4 - River Park)
(2)
Ohio Str.
21+99.64
(Blk. 3)
River Park
26+49.32
26+40.62
Nebraska
27+15.32
27+55.31
S.0°00'53"E
Ellis Av.
N64°-45½'W to Ctr. Sugar Factory Cheyenne
7
South
6
stake
26th Str.
10
11
N42°27'E Eyrie
Curtis
15
14
76.09
450.0
27th
S89°02'E
S89°-02'E
stake
600
Blk. 6 - Fairmount Park Annex
7.91
S.24°39'E
297.7
N.W. Cor.
Globe Mill
19.61 ac.
Sheds
Colorado Ave. South 1424.0
Flag pole on top of mill
600.0
S89°02'E
N. Line of alley
stake = 120 ft. S. of N.E. cor Blk. 2 -
stake = 120 ft. S. of N.W. cor. Blk. 2 -
Wire Fence
John Baird
Box 339
R.F.D. 2
Survey of Globe Milling Co. land in Fairmount Park Annex Dec. 2-1919
Being N.½ of Blk. 2 + all of Blks 3-4-5 & 6