See Plat Book - page 2 & 57
4 H. Jan 25
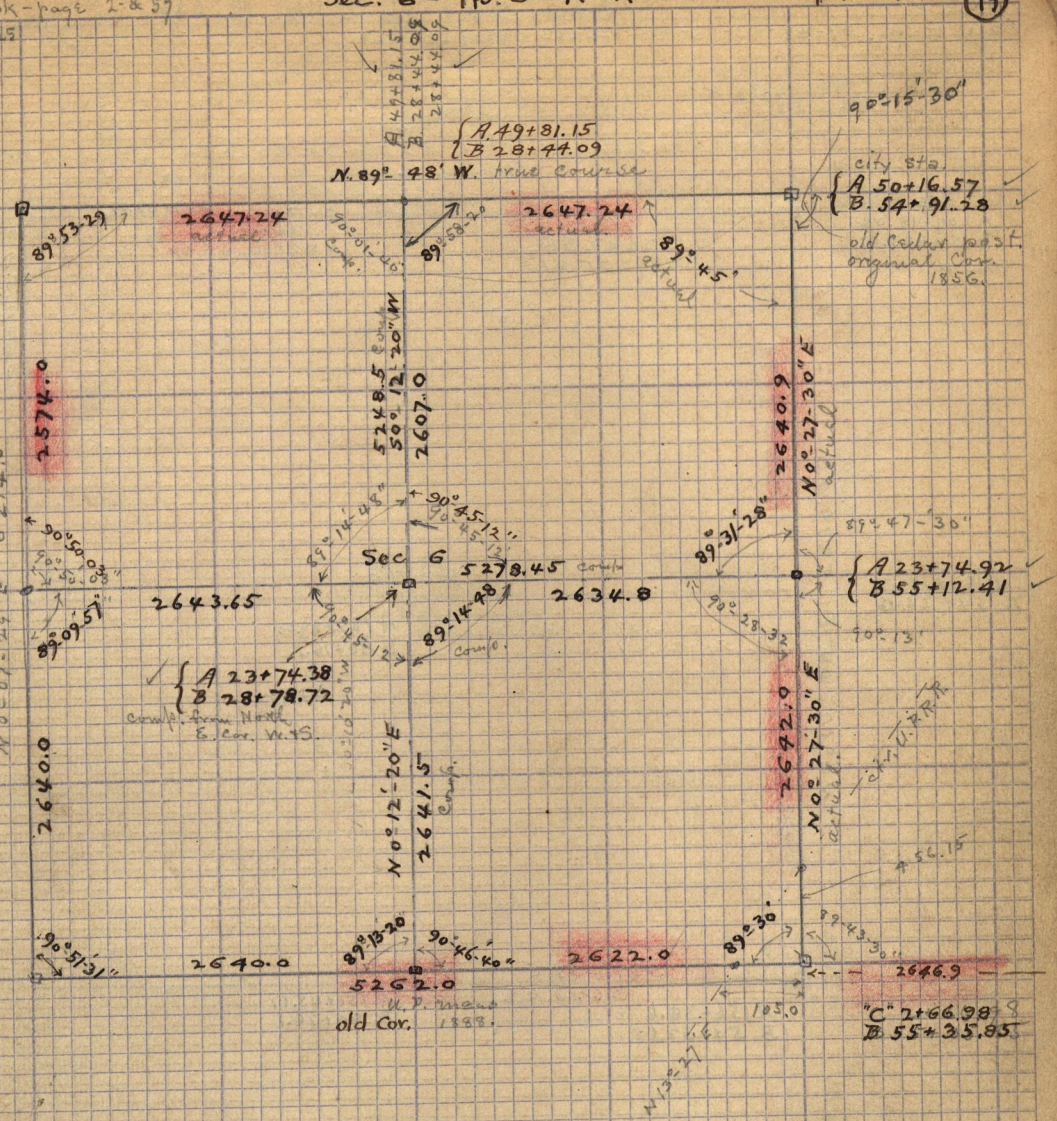
Sec. 6 — Tp. 5 - N - R. 1W — Jany 7 - 1919