


(22)

Sec. 24 T. 6 - N. R. 2 W.

July 16 - 1918

Flat Book pg 97-120

Book L-196 - I pg 70-D92-

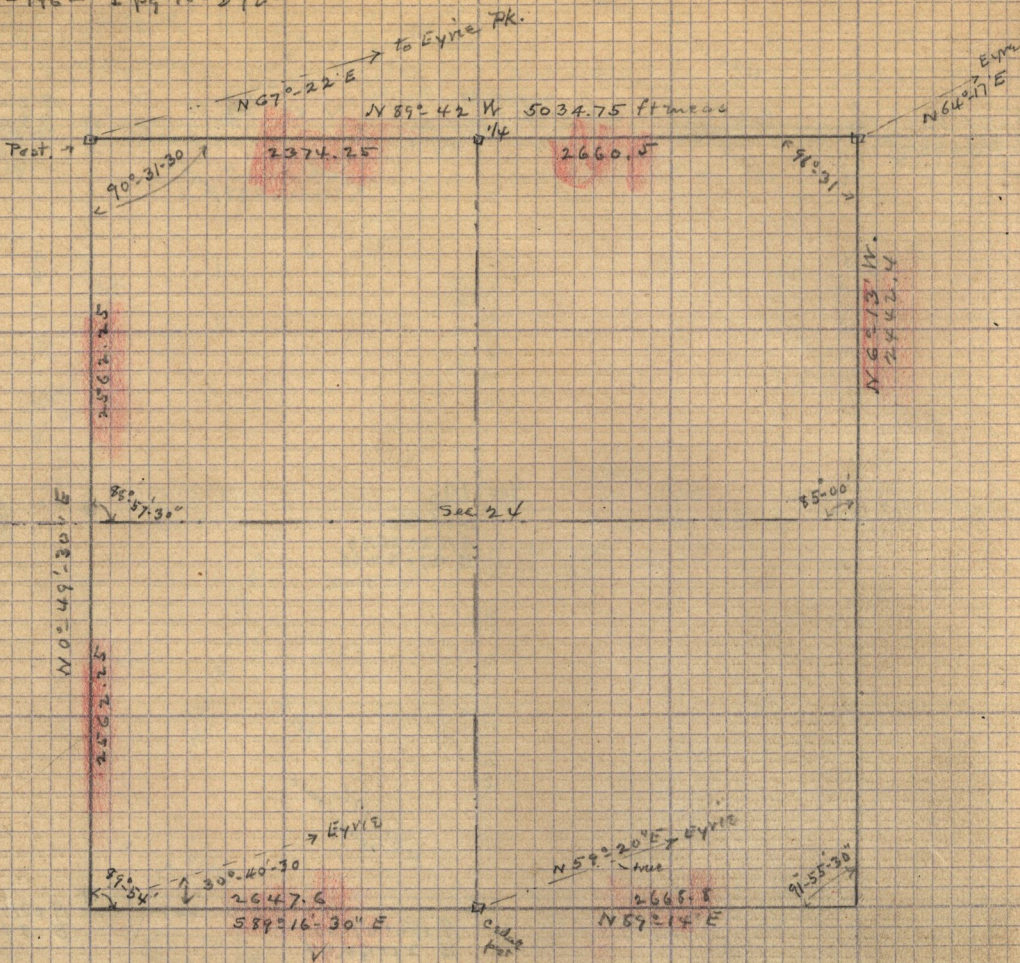

5300