Sec. 17 — T. 6. — N. R. 1. W. Feb. 2-1919.
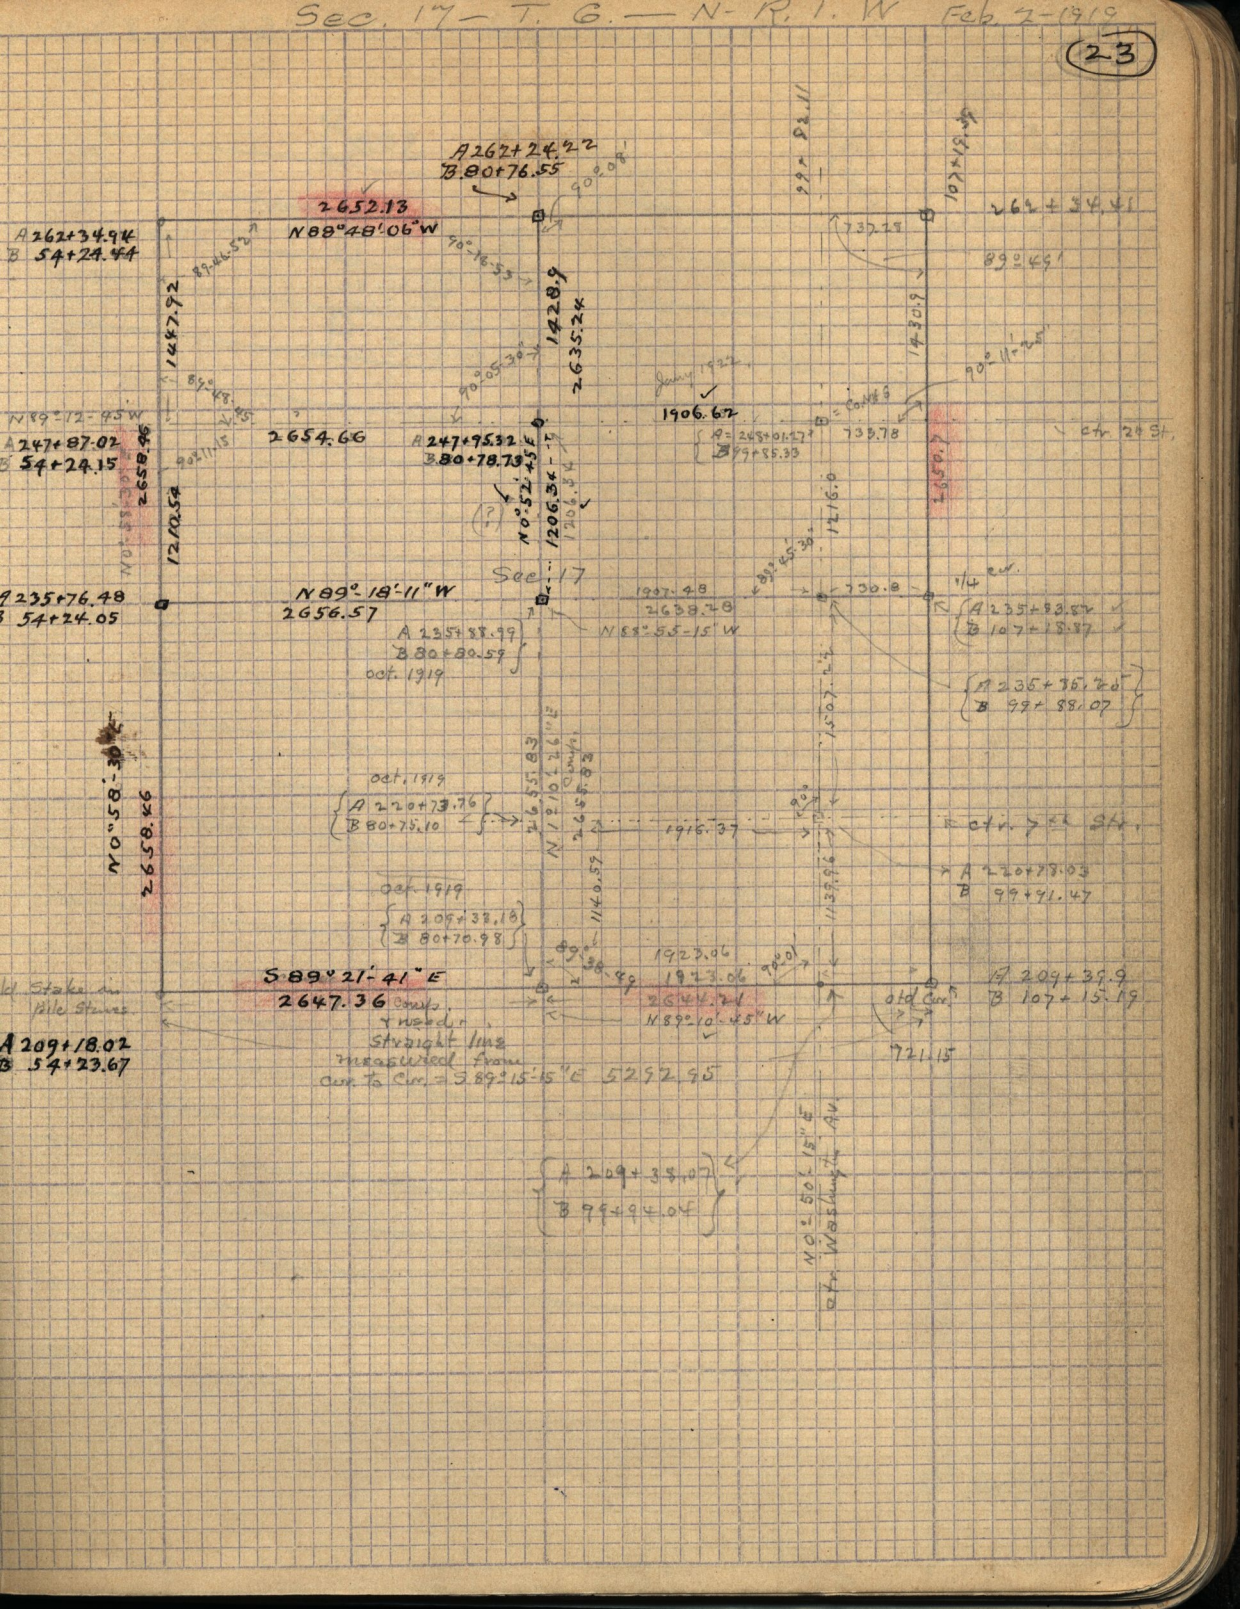
(23)