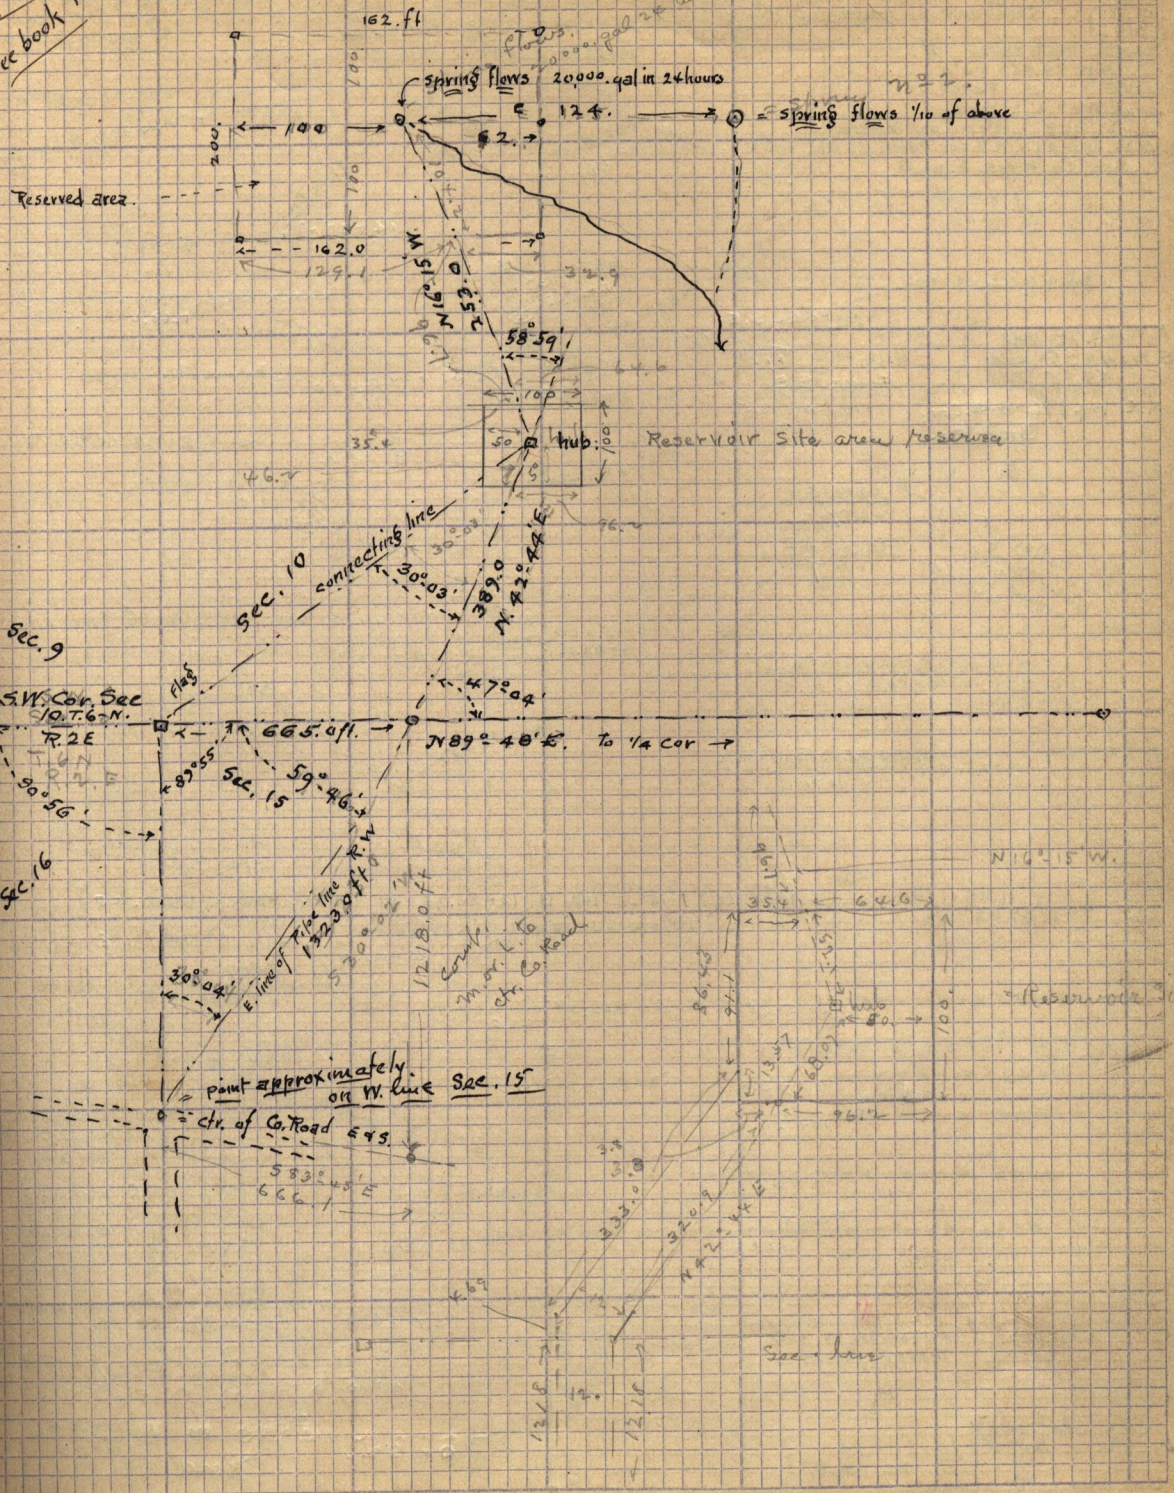Nov. 12-1919. Survey for Bp. Bingham of Ogden Valley — in Sec. 10 T.6N.R.2E