


Hub, in ctr. of Wilson Lane runs N 85° 28' 30" W.  
(See page 37)

{ A 132 + 30.13 }  
{ B 21 + 60.59 }

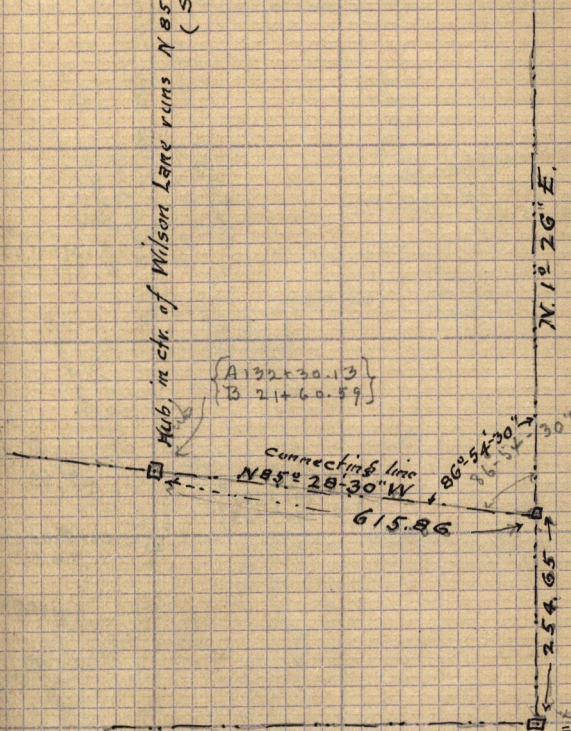

Hub. { A 131 + 91.91 }  
{ B 27 + 73.26 }

{ A 129 + 37.27 }  
{ B 27 + 73.19 }

S.E. Cor. of N.W. 1/4  
Sec. 30. T.G. N.T.R. 1 W