


Apr. 7-1920 Co. Road - Wilson Lane

The measures to bridge are taken to the top, outside corners.

(47)

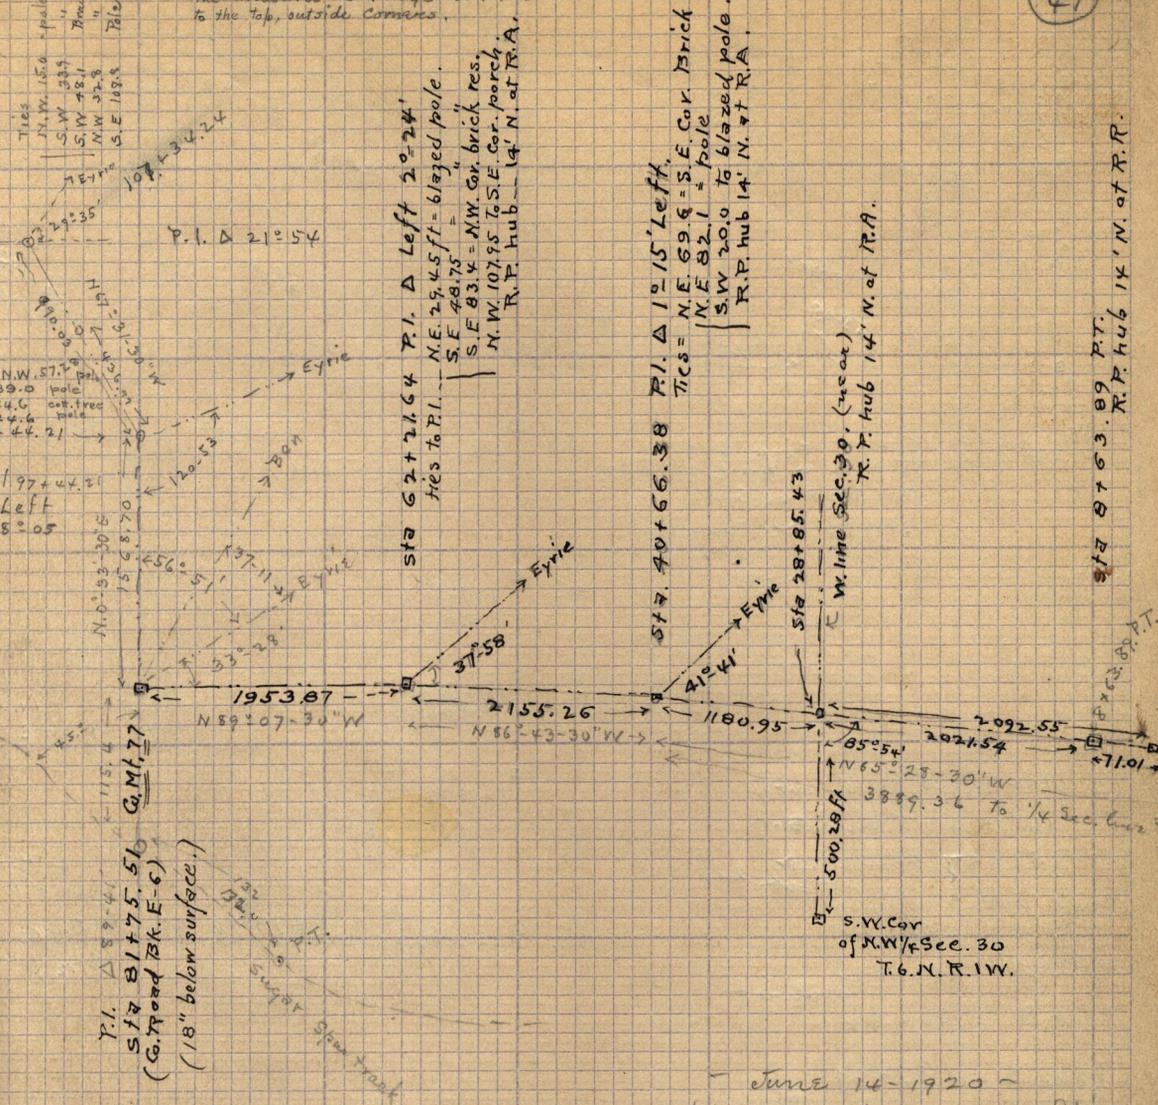

Nov. 24-1919
 N.E. 42.6 ft - blazed pole
 N.W. 32.62 " " "
 S.W. 25.02 " " "
 S.E. 66.90 " " "

P.I. Δ 89° 41'
 Sta 81+75.51
 (Co. Road B.R.E-6)
 (18" below surface.)

Sta 62+21.64 P.I. Δ Left 2° 24'
 ties to P.I. - N.E. 29.45 ft = blazed pole.
 S.E. 48.75 " "
 N.W. 83.4 = NW cor. brick res.
 R.P. Hub 107.95 to S.E. Cor. porch
 R.P. Hub - 14' N. of R.A.

Sta 40+66.38 P.I. Δ 1° 15' Left.
 Ties = N.E. 69.6 = S.E. Cor. Brick res.
 N.E. 82.1 = pole
 S.W. 20.0 to blazed pole.
 R.P. Hub 14' N. of R.A.

Sta 28+85.43
 R.P. Hub 14' N. of R.A.

R.P. Hub 14' N. of R.P.
 R.P. Hub 14' N. of R.P.

June 14-1920

Traverse table - beg. at lat 254.65 ft
 on 1/4 Sec. line N 1° 26' E from S.E. Cor. of N.W. 1/4
 Sec. 30 - T. 6.N. 1/4 W. along Co. Road

	N	S	E	W
3889.36	N 85° 23' 30" W.	306.84		3877.24
2153.26	N 86° 43' 30" W	123.13		2151.74
1953.87	N 89° 07' 30" W	29.84		1953.64
1568.70	N 0° 33' 30" E	1568.63	15.29	
990.03	N 67° 31' 30" W	378.46		914.83
254.65	N 1° 26' E	254.57	6.37	
From O	N 1° 26' E	143.29	3.71	
		2809.76	25.37	8897.45