Apr. 29 - 192

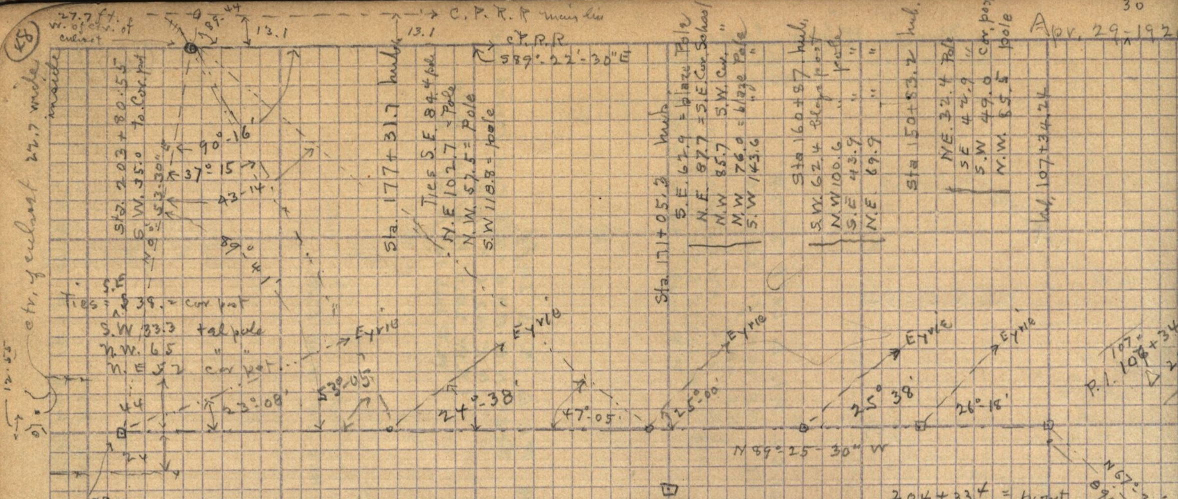

197 + 21. Fence South
195 + 22. ctr. Hooper Canal Culvert
190 + 58 Fence South
181 + 78 ctr. Town line

hub 203 + 80.55
2.6 W. of ctr. St. South

204 + 33.4 = point
12.55 ft. W. of ctr. of culvert

hub 177 + 31.7
2' W. of 1/4 line

hub 171 + 05.3
S. of School.

169 + 76.
169 + 26.3 = E.

164 + 12.5 Fence South
157 + 49 Fence S.
157 + 67 ~~Fence~~ ctr. Town line

160 + 87 = hub
18 ft. W. of ... S.

Fence South 145 + 44
Fence 142 + 82 culvert
Fence S 140 + 32
fence S 137 + 67
131 + 10 = fence South

Hub. 150 + 83.2

150 + 88 Fence
147 + 74 canal crosses Str.

129 + 79
125 + 59 = ctr. Canal
124 + 50.3 1/4

111 + 96
ctr. Hooper Culvert

107 + 83.24

107 + 34.24 P.I.