

Z

Bridge

{ width of
Bridge off
e/w }

26.4' ft. (L.M.P. pipe under
Bridge)


25.4' ft. (power pole
& R/W Fence
also)

(39.0' ft fence
line)

(START
culvert
25.2' Lt
& Ditch)

5900 So.

(26.4' Lt.
power pole
& R/W
fence)

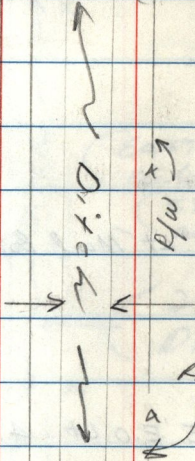

(11.0' wide ±
pitch)

21.40' R/W
Lt.
(WEST culvert
pipe 18")

(EAST 21.40'
Lt.)

(Ditch Ends)
(conc. pipe 24.0' Lt.)
(tele pole 38.0' Lt.)
(phone June. Box
36.85' Lt.)

(25.1' Lt
to
culvert
Tele. pole
(25.0' Lt)