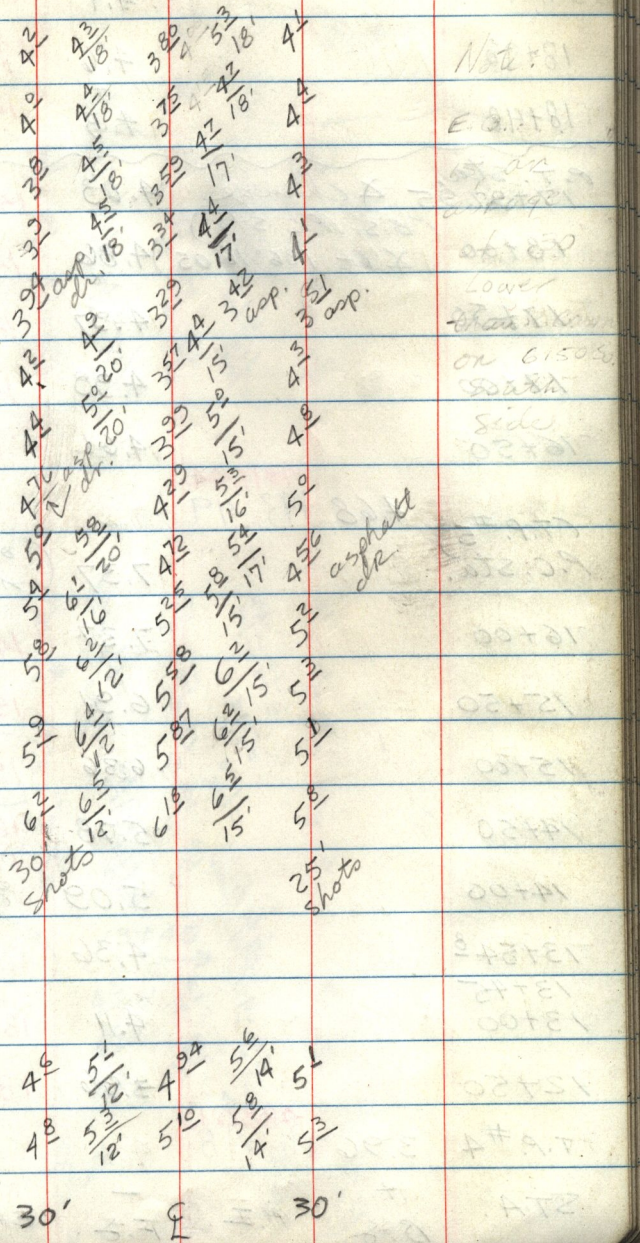
℄
4.2 4.3/18' 3.8 5.3/18' 4.1
4.0 4.4/18' 3.7 4.2/18' 4.4
3.8 4.4/18' 3.5 4.7/17' 4.3
3.7 4.5/18' 3.3 4.4/17' 4.1
3.9 asp. dr. 3.2 3.4 asp. 3.5 asp.
4.2 4.3/20' 3.5 4.4/15' 4.3
4.4 5.0/20' 3.9 5.0/15' 4.8
4.7 asp. dr. 4.3 5.3/16' 5.0
5.0 5.8/20' 4.7 5.4/17' 4.6 asphalt dr.
5.4 6.1/16' 5.2 5.8/15' 5.2
5.8 6.2/12' 5.5 6.2/15' 5.3
5.9 6.4/12' 5.7 6.2/15' 5.1
6.2 6.5/12' 6.1 6.3/15' 5.8
30' shots 25' shots
4.6 5.1/12' 4.9 5.6/14' 5.1
4.8 5.3/12' 5.0 5.8/14' 5.3
30' ℄ 30'