


325.60 hub.

$$\begin{array}{r}
 417.75 \\
 \underline{208.55} \\
 209.20 \\
 33 \\
 \hline
 176.20
 \end{array}$$

209.20  
 156.42

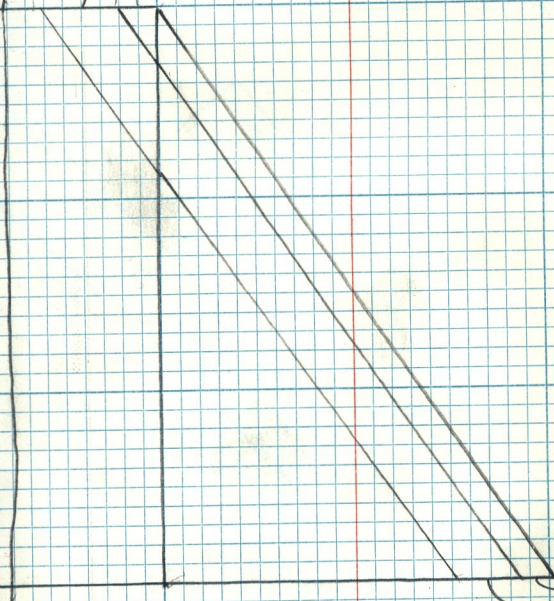

52.13  
 208.55

52.13 - flag  
 156.42  
 208.55 hub