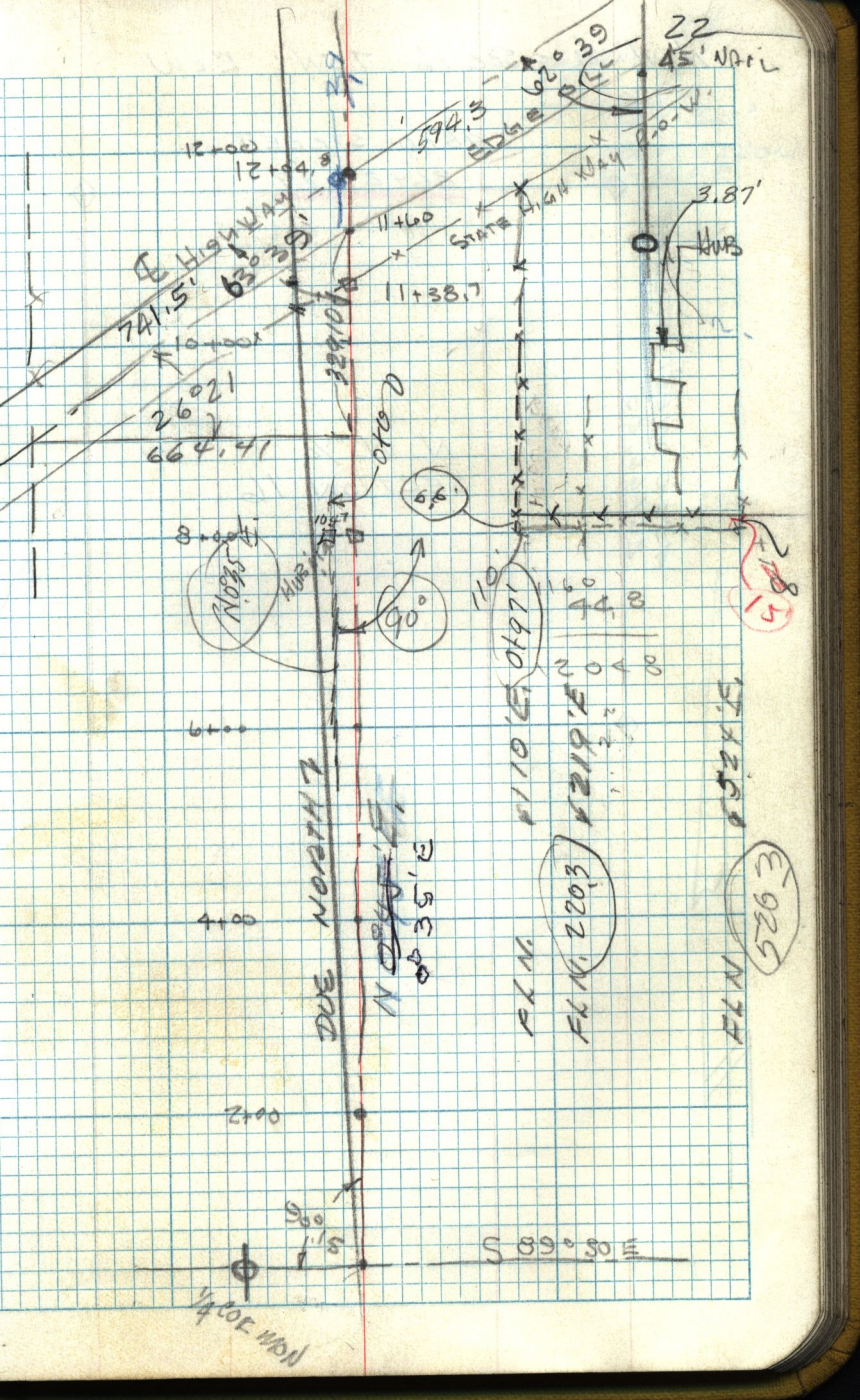
22
594.3'
EDGE
12+00
11+60
11+38.7
3.87'
HUB
741.5'
63°
26.02'
664.41'
10+00
8+00
6+00
4+00
2+00
6.6'
90°
110'
74.8'
525.3'
