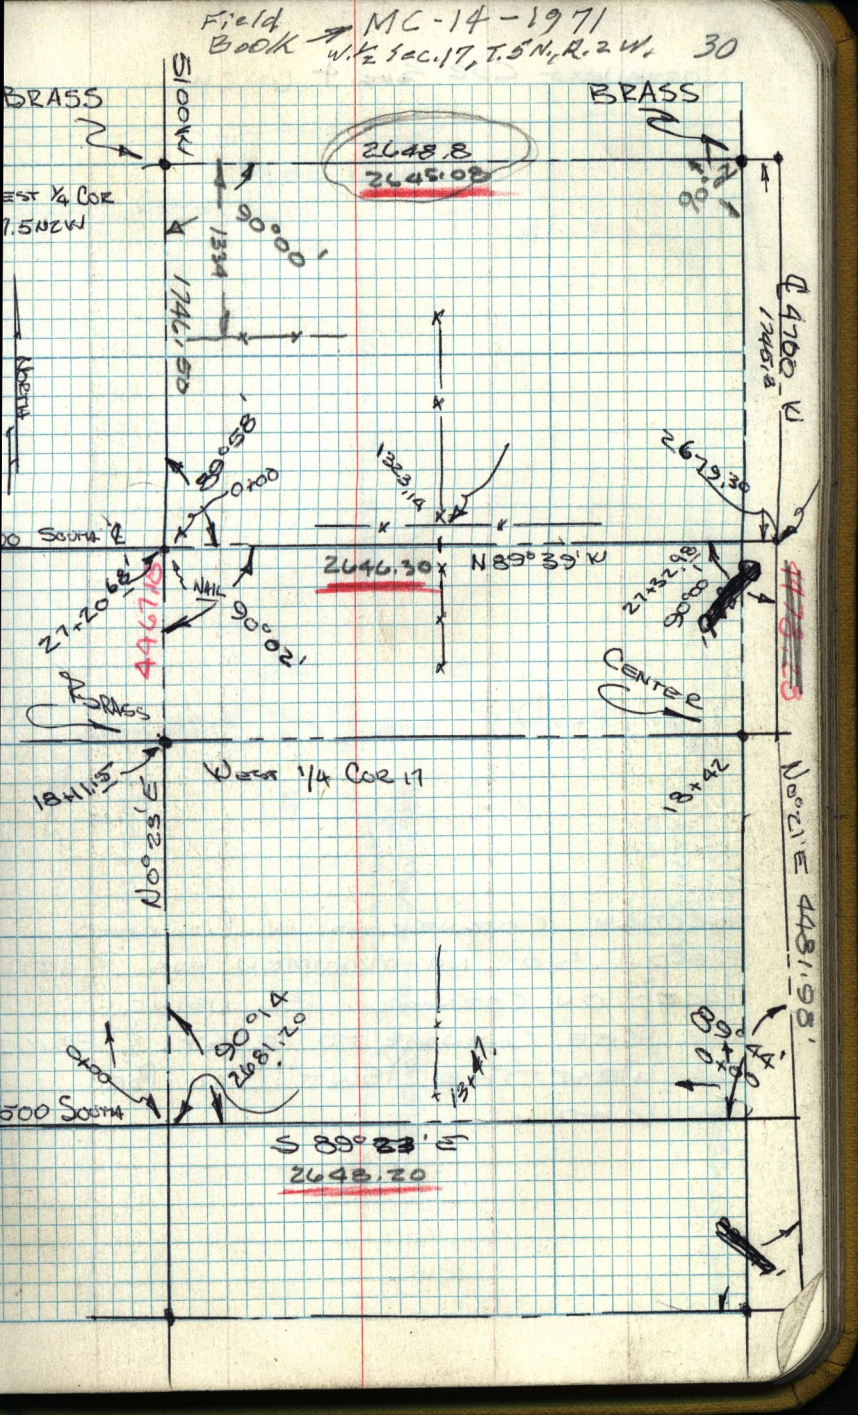Field Book → MC-14-1971
W. ½ Sec. 17, T. 5 N., R. 2 W. 30