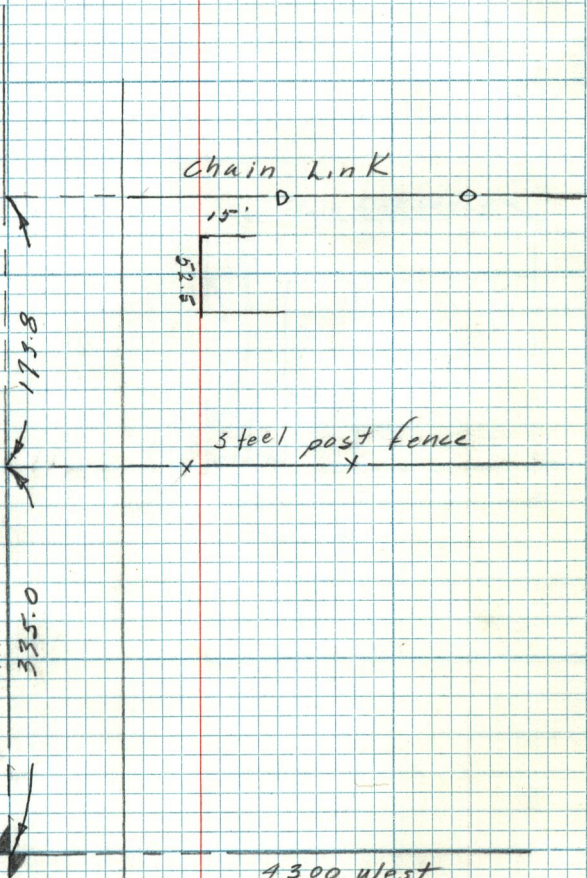
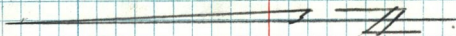


$$\begin{array}{r}
 67.5 \\
 15 \\
 \hline
 52.5
 \end{array}$$


7800 So.

Sec. line

173.8

335.0

15'

52.5

steel post fence

1300 West

Chain Link