

REF

TO

$\frac{1}{4}$ $\frac{12}{12}$
FG

6N 1W


(2)

(223)

Line 223

PIONEER
SCHOOL

(13)

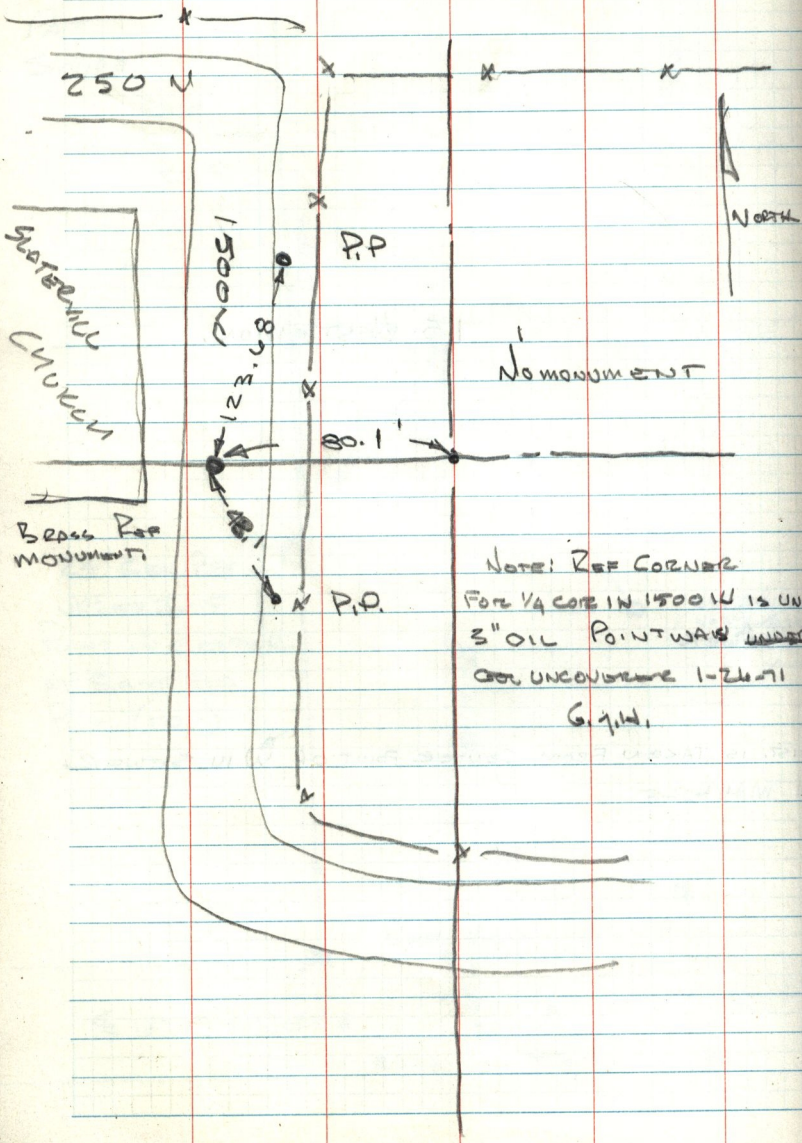

SATEMALL
CHURCH

250 N

1500 S

123.48

80.1

P.P.

P.P.

NO MONUMENT

NORTH

Base for
MONUMENT

NOTE: REF CORNER
FOR $\frac{1}{4}$ COR IN 1500 W IS UNDER
3" OIL POINT WAS UNDER
G. UNCOVERED 1-26-71
G. J. H.