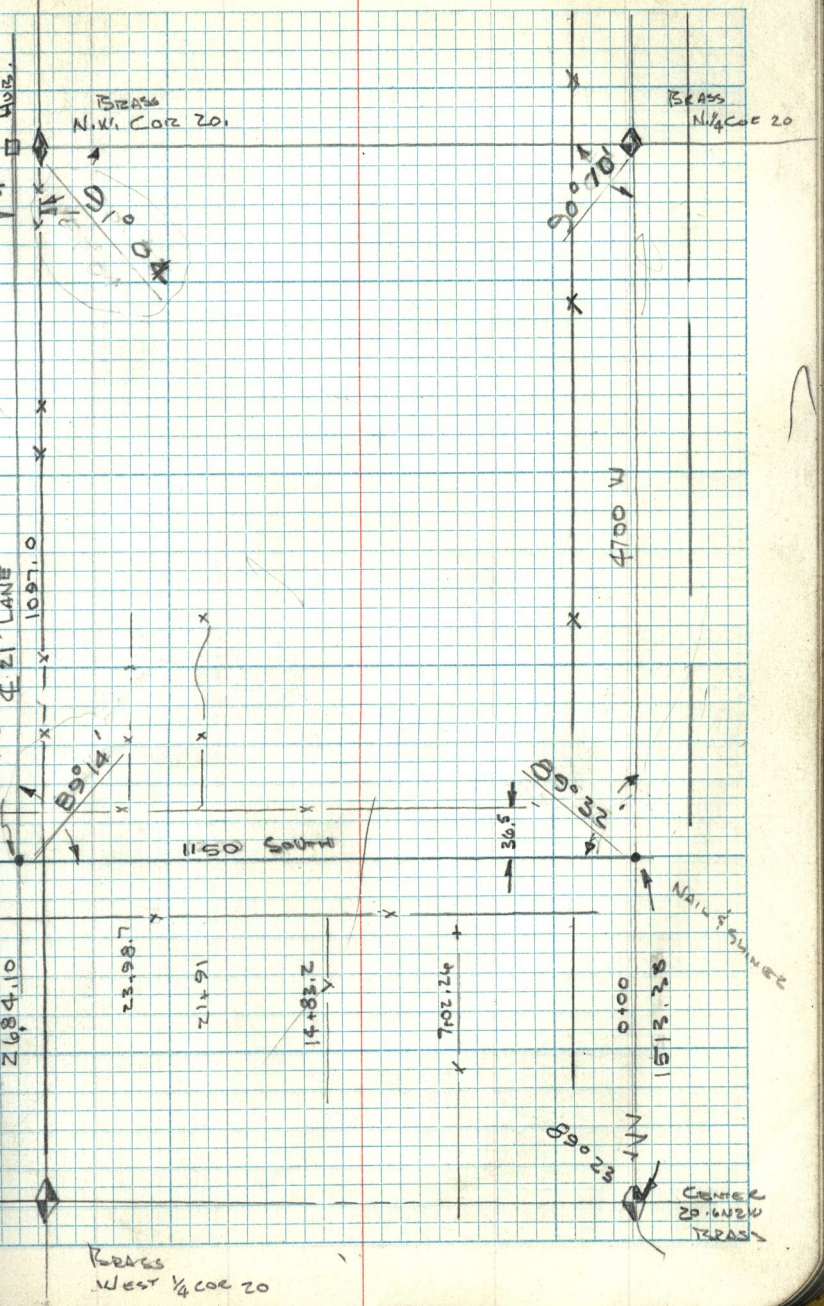
BRASS
N.W. COR 20.
BRASS
N.1/4 COR 20
90°10'
4700 W
1097.0
℄ 21 LANE
89°14'
89°32'
36.5
1150 SOUTH
NAIL & SLINGER
2684.10
23+98.7
21+91
14+83.2
7+02.24
0+00
1513.38
89°23'
CENTER
20.6N2W
BRASS
BRASS
WEST 1/4 COR 20