

N. E. 0-5

N. EAST ROAD OIL


3500 EAST

EAST ROAD OIL

N
N
SECTION LINE

x EAST 12.0-14

NORTH

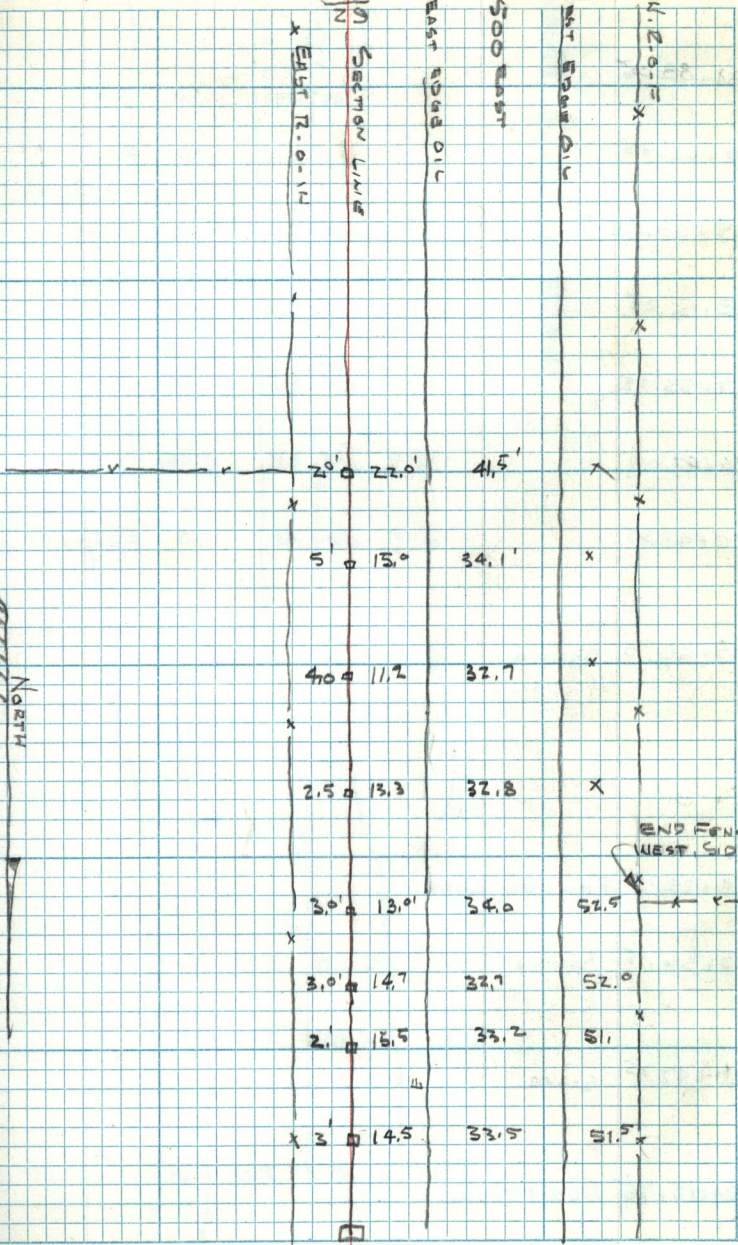

END FENCE WEST SIDE

20' 22.0'

41.5'

5' 13.0'

34.1'

40' 11.2'

32.7'

2.5' 13.3'

32.8'

3.0' 13.0'

34.0'

52.5'

3.0' 14.7'

32.7'

52.0'

2' 15.5'

33.2'

51'

x 3' 14.5'

33.5'

51.5'