


58.1 Pipe,

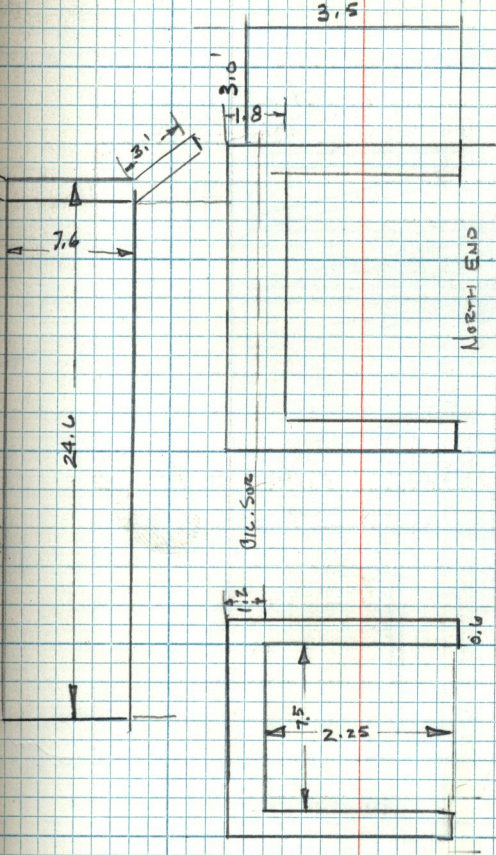

NORTH END

SOUTH END

FLOW OF WATER IS FROM SOUTH TO NORTH.