
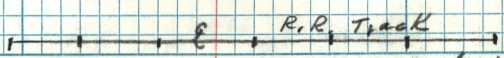


E 5700 West

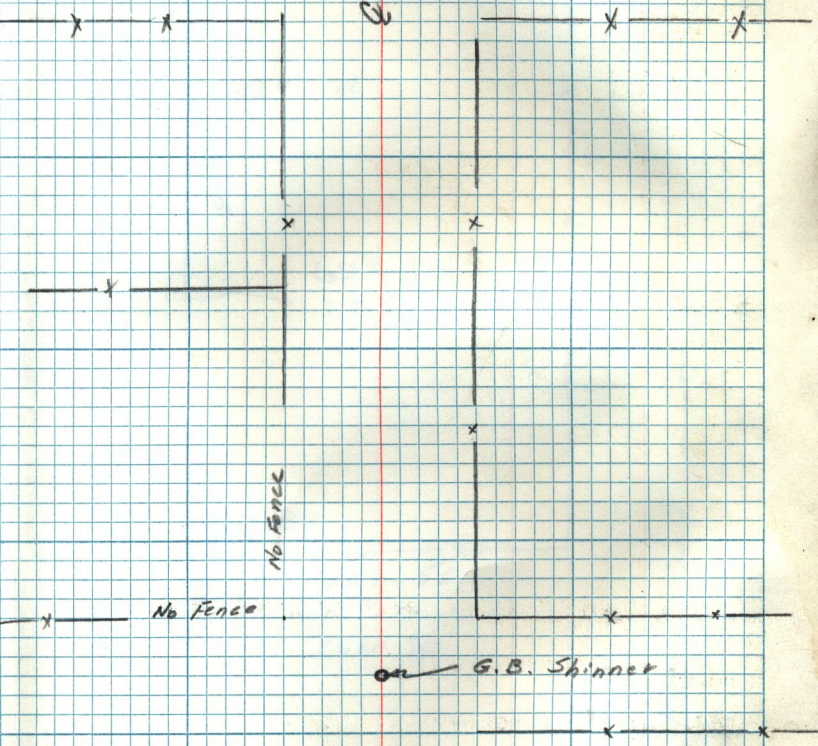

Note: Monument not m. Covered by 4' Fill