


MAY 19-71

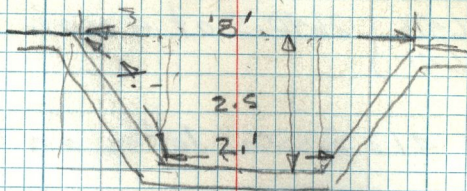

CONCRETE DITCH WILSON IRG CO
 2900 W BETWEEN 2900S 3500S

1 1/2 UP POST

