877.1
304.06
573.04
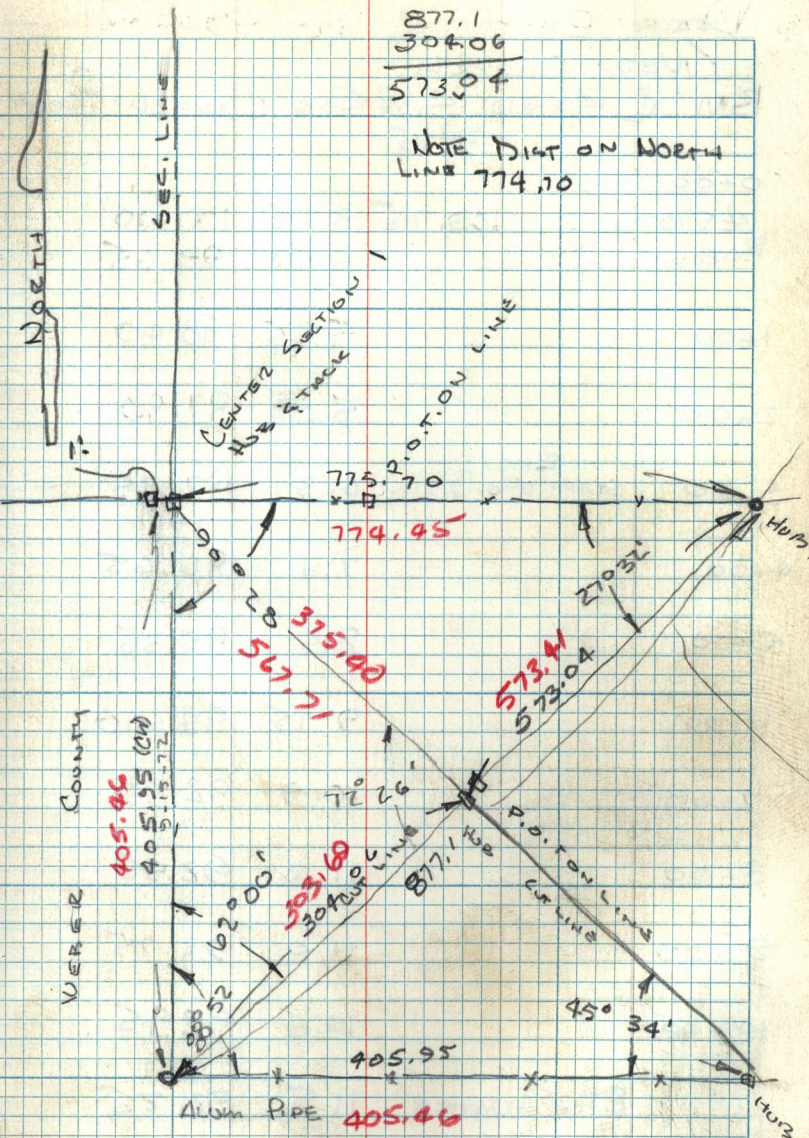
NOTE DIST ON NORTH LINE 774.10