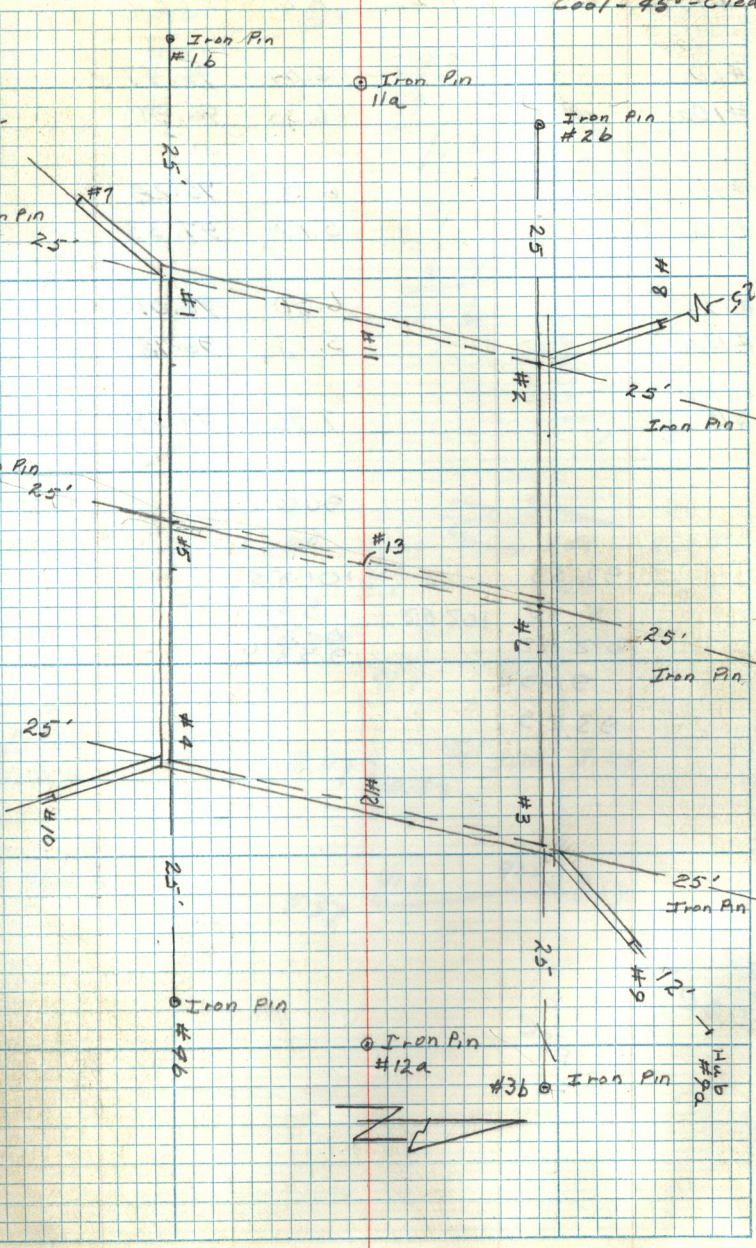11-9-72 54
G. Hill
S. Patterson
Cool - 45° - Clear