


$$\begin{array}{r} 268 \\ 88 \overline{) 30.800} \\ \underline{976} \\ 3320 \\ \underline{2928} \\ 3920 \\ \underline{3904} \\ 16 \end{array}$$

$$\begin{array}{r} 58 \\ 60 \\ \underline{3480} \\ 30 \\ \underline{3510} \end{array}$$

$$\begin{array}{r} 29.15 \\ 2 \overline{) 58.30} \\ \underline{58} \\ 30 \end{array}$$

$$\begin{array}{r} 31 \\ \cdot 872 \\ \underline{150} \\ 43600 \\ 872 \\ \hline 130.800 \\ 130.8 \\ \hline 261.600 \end{array}$$

GATE.

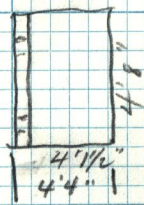


$223.65 - \Delta = 58^{\circ} 30'$

$$\begin{array}{r} 30 \\ 1150 \\ \hline 130.8 \\ \sin \end{array}$$

$$\begin{array}{r} 11042' \\ 5 \overline{) 5830'} \\ \underline{5} \\ 3 \end{array}$$

$11^{\circ} 42'$

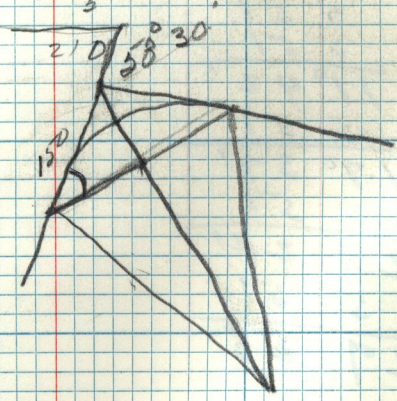

(1)  $11^{\circ} 42'$

(2)  $23^{\circ} 24'$

(3)  $35^{\circ} 06'$

(4)  $46^{\circ} 48'$

(5)  $58^{\circ} 30'$