


TYPICAL X SECTION ON
 PATIO SPRINGS SEPT 10, 74

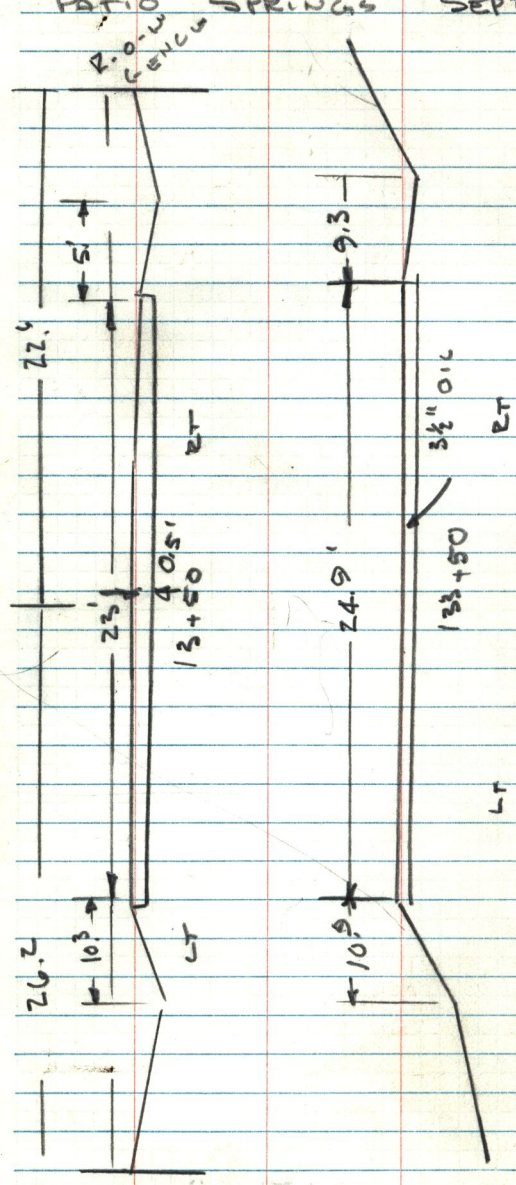

R.O.W.
 FENCE