


①

NORTH 1/4 CO. 29

7N1E

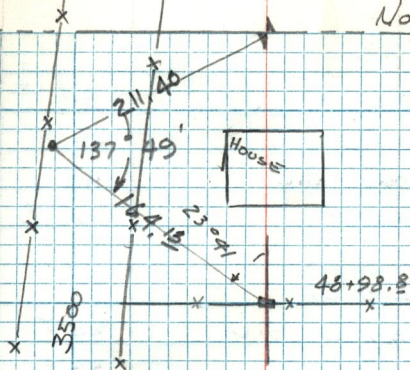

55+17.3 3300N.

SPIKE ON SEC. LINE