

98.75

97.20

98.75

15

6.10
10 3.30

96.39
2.36


1-31-74

Cloudy 58°

π Stn. Patterson

φ Chris Minnoch

Job No. MC-74-2

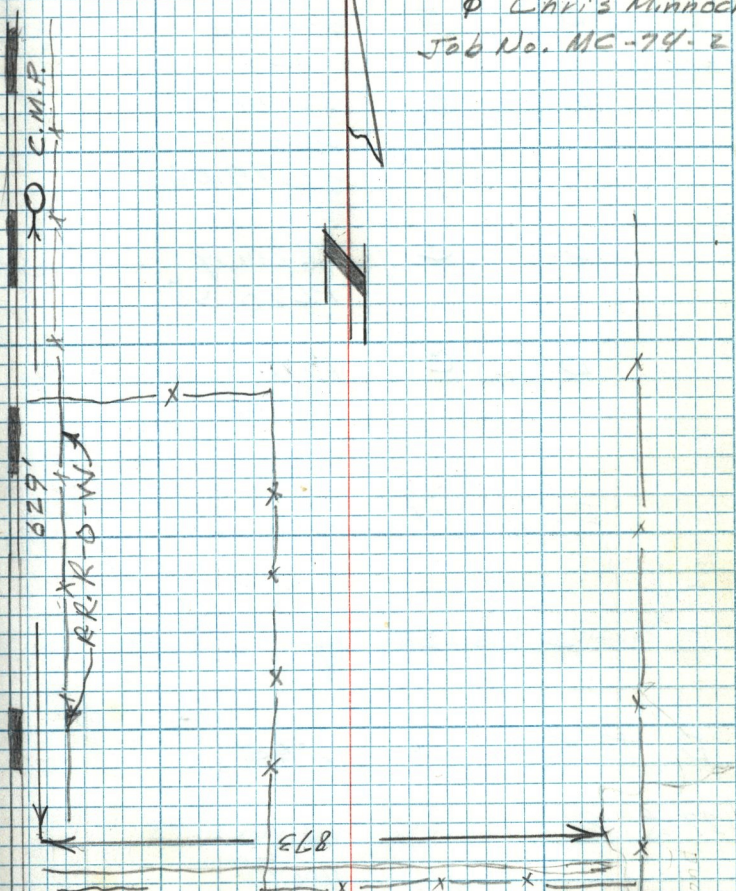

STADIA READINGS

TOP	7.9	7.83	7.55	7.74
BOT.	2.0	1.0	4.00	5.00
	590	3.83	3.55	2.74

3.83
873
355
1228
279
1502 TOTAL