


NORTH FORK IN WEBER CO. NORTH FORK  
 SOUTH END, WEST OF MC18-  
 BEN LOMOND STAKE CAMP  
 10-17-74 T.F.W. M...  
 CH. SCOTT PROJ.  
 INERT COND.

N. 1/4 COR. SEC. 12  
 T. 7N, R. 1W.

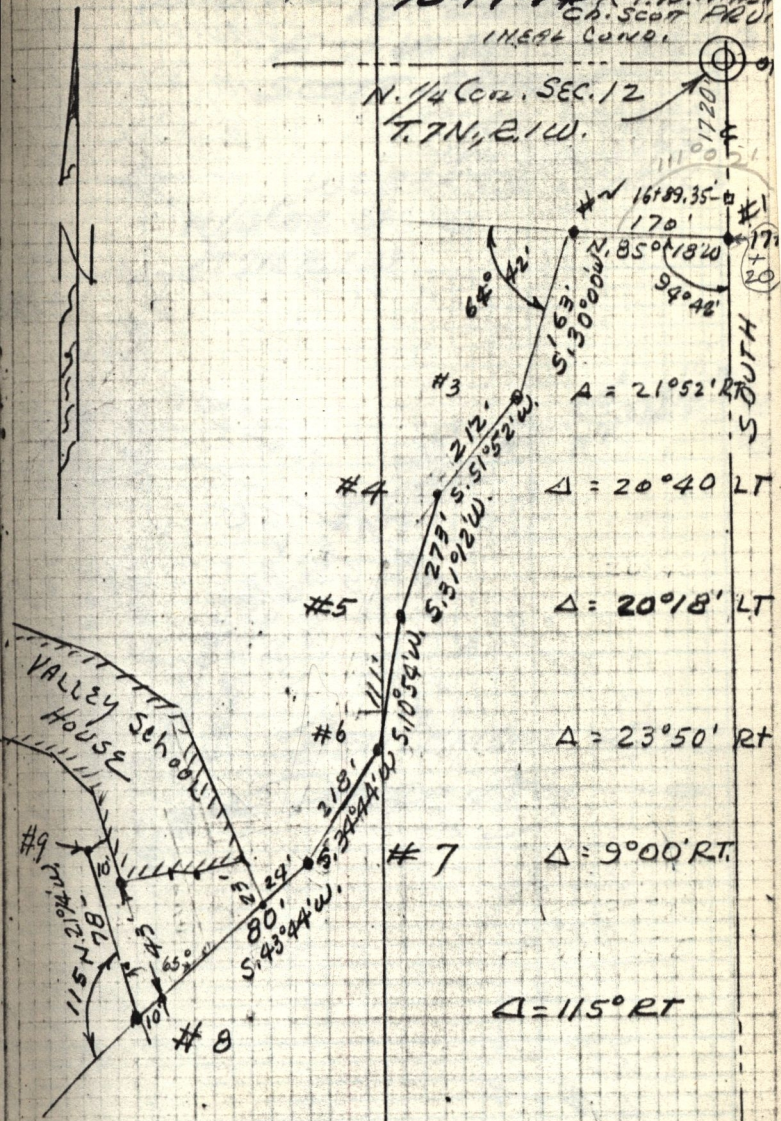

Cont. over