13
-5.2
7.9

24' E on trail
+26' E on trail
23' N on trail 0.0 Rod
NW Corner Fence (Combe-Storey) 60' wide
⊼ Pt 2 on Fence line

Fence 15 Rt

P.I. "B" Line Fence 18' Rt (N)
R.R. Spike (Toe of Stope. 41+81.84 "B" Line
50' South

41+81.68 N.S. Fence 8' S. of Corner
24' N of
40' W of 41.31.6
50' S of Corner
50' S of P.T.

11.4
1.1
12.5

Pt "C" 54' from ⊼ 104' from Corner of Fence
65.8 To PT " " "
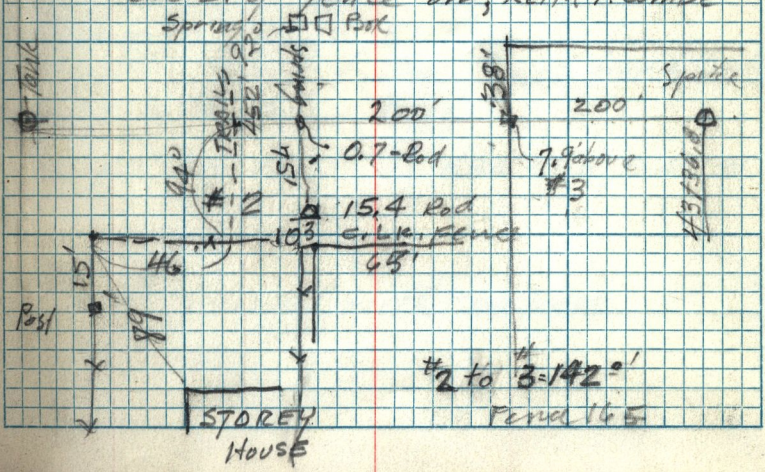
P.O.T. 43+36.84 to P.I. (South of Tank Line
200 E. of Fence on, Keith P. Combe