H. Young (8)

Canal Location
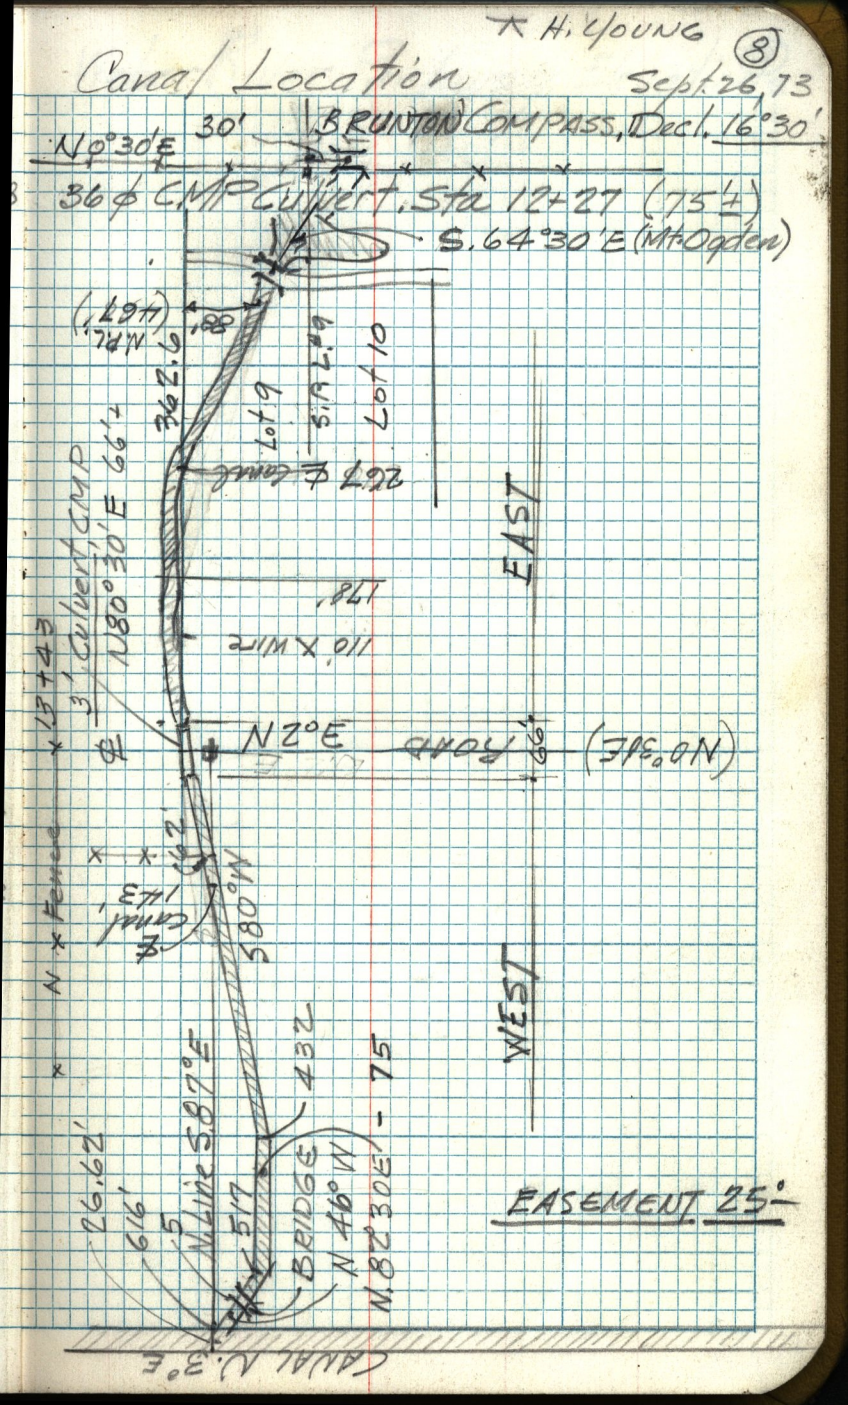
Sept. 26, 73