


1/4 BETWEEN 32/33 T1N, R1W
SLBM

HILL
SHOPS

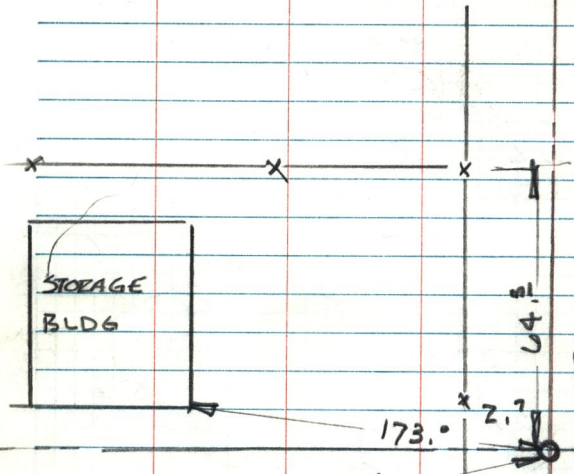

WEBER COUNTY
BRASS MONUMENT

REPLACED 3x2"
HUB, ON MAY 29
74.

