


CULVERTS ON FIRST STREET

JULY 1, 74
HILL, STAKE


7200 E

○ C.M.P


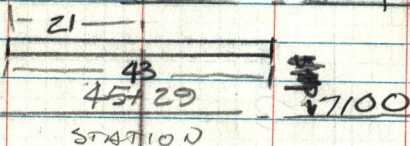


7000 E


15" ○ C.M.P

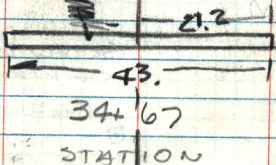



6900 E

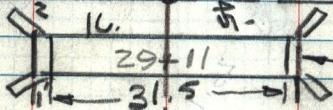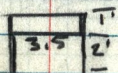

C.M.P
15" ○

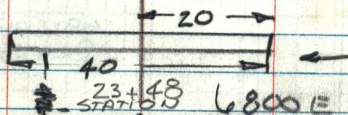

6800 E

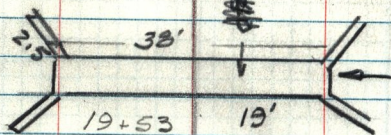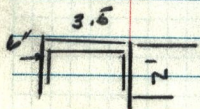

CEMENT BAY