



7500 E

18" O C.M.P.

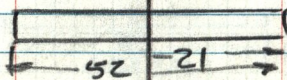


STATION 64+82

15" C.M.P. WITH CEMENT

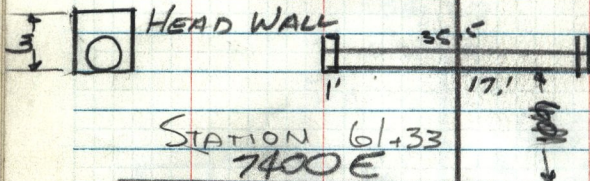

STATION 61+33
7400 E


24" O.C.M.P.

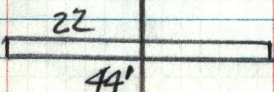

STATION 59+43

7300 E


18" O C.M.P

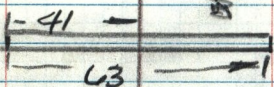

STATION 53+24

7200 E

15" O C.M.P

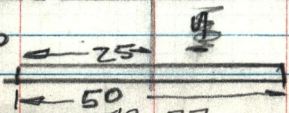

STAT. 47+77