


9 mile Br.

128.5 x 2.5 set south 2/28/73

100' overall

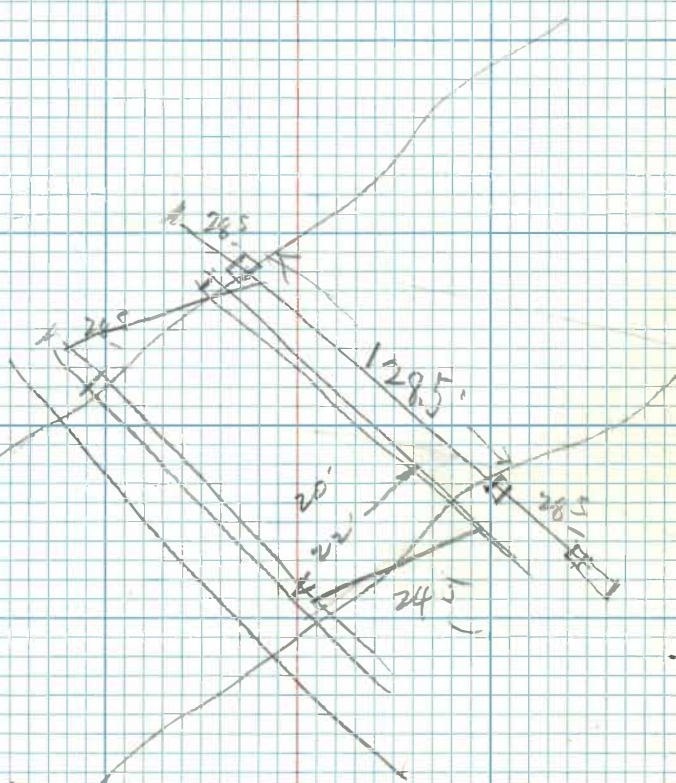

$$\begin{array}{r} 20 \\ \hline 24.5 \end{array}$$

35° 17'